

Ellis


KANSAS

SECTION 7 TOWNSHIP 12 RANGE 17W

WELL NO. #2 Herman

COMPANY Sierra Petr.

NORTH NE NW NE

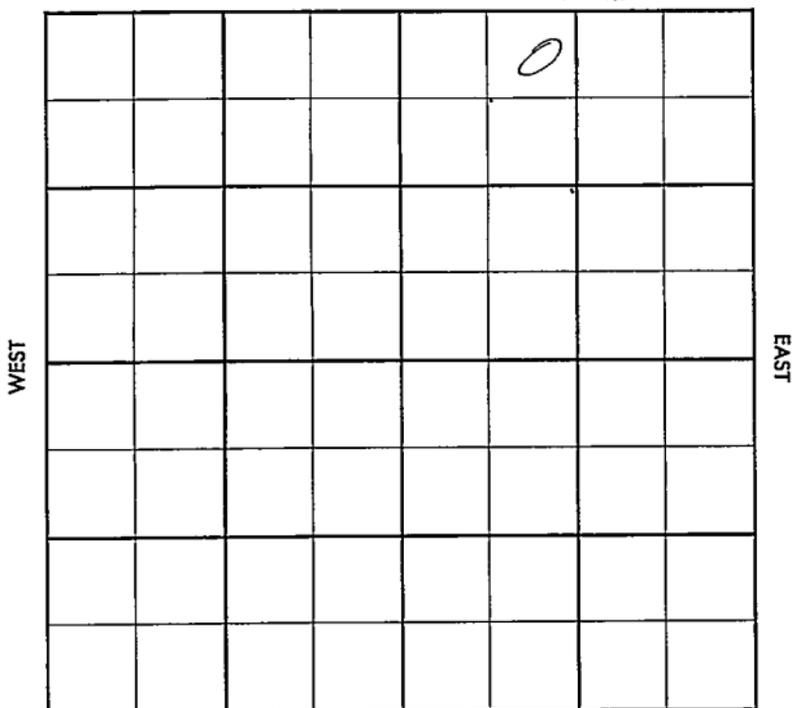

SOUTH

County Ellis Elev. _____
 Sec. 7 Twp. 12 Rgs. 17W
 Company Sierra Pet.
 Farm Name Herman No. 2

TOPS	DEPTH	LOG	DATUM	Loc. in Sec.
Anh.				NE NW NE
TP.				
H.				
Tr.				
Dg.				
Bl.				
L.				Geol. _____
K.C.				Contr. _____
B.K.C.				Co. tools
Ce.				Pool
C.				Bemis-Shutts
M.				
M.				
K.				
Mz.				
Me.				
V.				
S.				
S.				
A.				
R.				
PE.				
G.				
T.B.				

0
 JAN 30 '57
 FIRST REPORT

Date Comm. 1-28-57
8" @ 221/140 WOC

(Handwritten mark)

Co.
Lse.
No.
Sec.
T.
R.

Co.

County Elis Elev. 2153
 Sec. 7- Twp. 12 Rgs. 17W
 Company Sierra Pet.
 Farm Name Herman No. 2

TOPS	DEPTH	LOG	DATUM	Loc. in Sec.
Anh.	1375			NE NW NE
Tp.	3123			
H.	3355			
Tr.				
Dg.				
Bl.				
L.	3400			Geol. _____
K.C.				Contr. _____
B.K.C.				Co. tools _____
Ce.				
C.				Pool _____
M.				Bemis-Shutts
M.				
K.				
Mz.				
Me.				
V.				
S.				
S.				
A.	3675			
R.				
PE.				
G.				
TD.	3760			

Use.

		0
	FEB 13 '57	
ABANDONED		

No.

Date Comm. 1-28-57
8" @ 221/140 WOC FEB 6 57 # 3450

Sec.

1-13-57 DST 3460-3500 1hr run
370' SW BHP 1155/20" DST
3675-80 30" run 10' Md BHP
135/15" DST 3675-86 1hr,
run 18' Md BHP 150/20"

T.

R.

D&A