

Ellis


KANSAS

SECTION 7 TOWNSHIP 12 RANGE 17W

WELL NO. #2 Walter

COMPANY Murfin Drfg.

NORTH

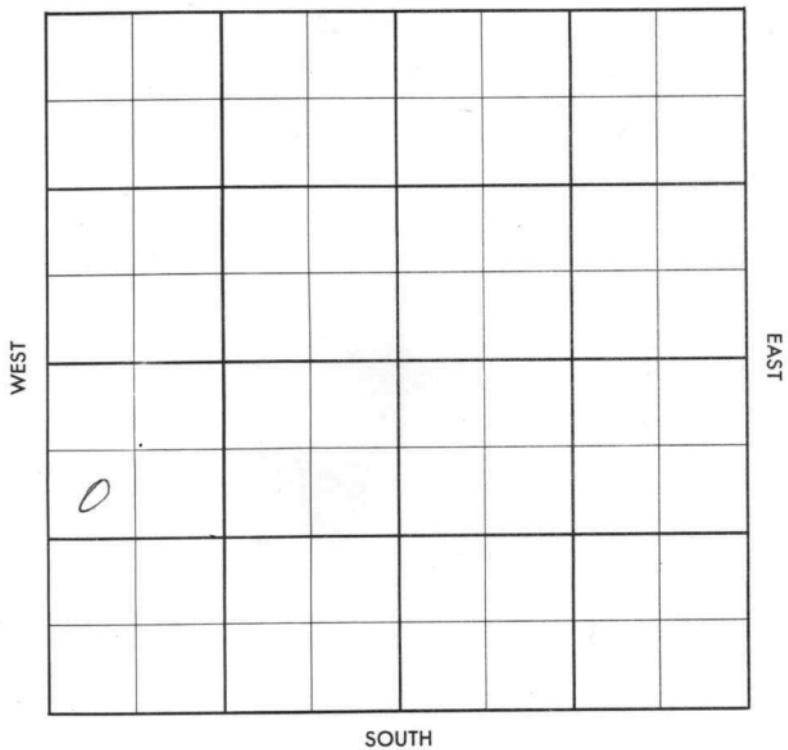

SOUTH

EAST

WEST

FORM 513 SUNRAY

County Ellis Co.
 Sec. 7 Twp. 12 Elev.
 Rge. 17W
 Company Murfin Drilg.
 Farm Name Walter No. 2

TOPS	DEPTH	LOG	DATUM	Loc. in Sec.	Lse.
Anh.				SW NW SW	
T.P.					
H.					
Tr.					
Dg.					
BL.					
L.					
K.C.				Geol.	
B.K.C.				Contr.	
Ce.				Co. Tools	
C.				Pool	
M.				Bemis-Shutts	
M.				SEP 26 '56	
K.					
Mz.					
Mq.					
V.					
S.					
S.					
A					
R.					
P€.					
G.					
T.D.					


FORM 513 SUNRAY

Co. ~~Ellis~~ 2168
 County ~~Ellis~~ Elev.
 Sec. ~~7~~ 12 Rge. ~~17W~~
 Twp. ~~Murfin Drig.~~
 Company ~~Murfin Drig.~~
 Farm Name ~~Walter~~ No. 2

TOPS	DEPTH	LOG	DATUM	Loc. in Sec.
Anh.	1405			SW NW SW
Tp.				
H.	3373			
Tr.	3391			
Dg.				
BL.				
L.	3418			Geol.
K.C.				
B.K.C.				Contr.
Ce.				
C.				
M.				
M.				
K.				
Mz.				
Ma.				
V.				
S.				
S.				
A.	3697			
R.				
PE.				
G.				
TD.	3700			

COMPLETE

NOV 7 '56

Date Comm. MIRT OCT 3 '56 85/8 187.
 D 3245- OCT 10 '56 9-25-56
 DST 3434-72 1hr 15' Md BH²
 0 FP 0 DST 3472-3576 CR
 1hr 30' 50' SPTD Md BH² 100
 5 1/2 @ 3698 1/2 MICT OCT 17 '56 CO DD
 3704 1/2 1/2 x 5 5 BFph 20% WL
 TCR OCT 24 '56 OCT 31 '56 Poy OCT 7 '56 X
 P. 30 Board 40% Wt Table "C"
 AHB 0.4 3698 1/2 - 3704 1/2 TD