


Section 7 Township 12 Range 17W

Well No. #1 Schmeidler

Company B & R Drig.

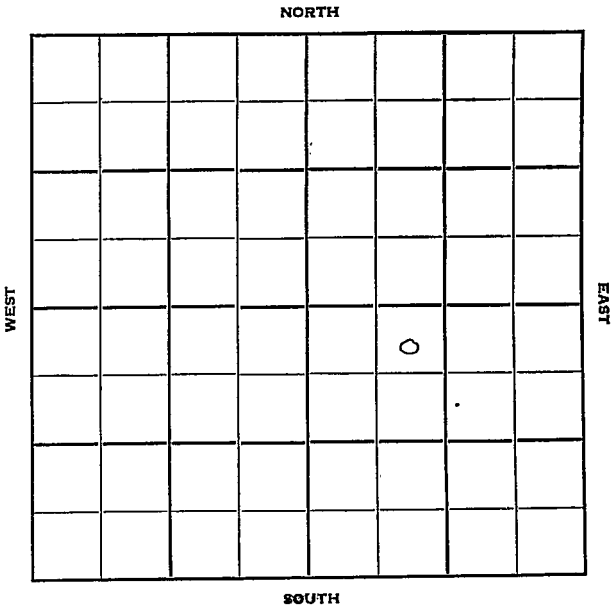

Sec. 7 Twp. 12 R. 17W

Well No. #1 Schmeidler Farm

B & R Drlg. Company

Contractor


Wildcat

330 Ft. from N. Line

_____ Ft. from S. Line

_____ Ft. from E. Line

990 Ft. from W. Line

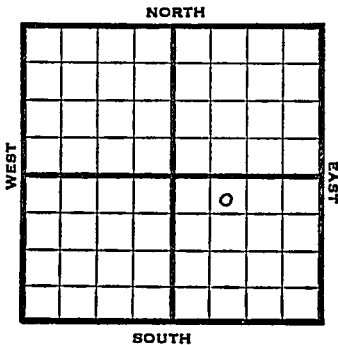

NE NW SE

1951

Eden. 211.6

REPORT

12/5

Spud 11-28-51
8" @ 187'
Anhy 1380'
Drlg. 2561'

12/19

Spud 11-28-51
D&A TD 3863
8" @ 187'
Anhy 1380 Heeb. 3402
KC 3448
TD 3863 D&A

ABANDONED

