


Section 8 Township 12 Range 17W

Well No. #1 Dreiling

Company Nadel & Gussman

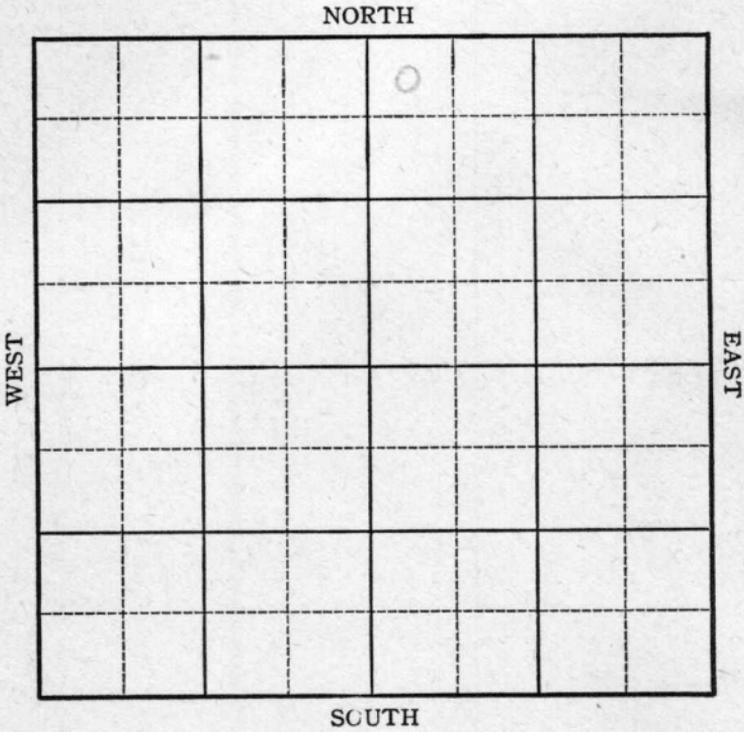

Sec. 8 Twp. 12 R. 17W

Well No. #1 Dreiling Farm


Nadel & Gussman Company
Shutts

330 Ft. from N. Line

_____ Ft. from S. Line

_____ Ft. from E. Line

330 Ft. from W. Line

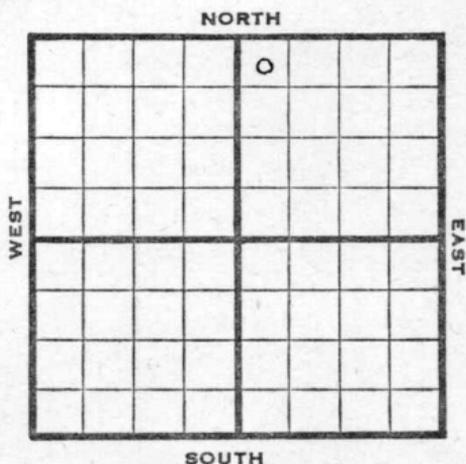

NW NE

R E P O R T

1945

3/14	R U R
3/23	13" @ 64'
	Drlg. 1155'
3/29	8" @ 1321
	Drlg. 2963
4/4	Lans 3350
	Cong 3587
	TD 3650'

ABANDONED

Pool Name Shutts

Map No. 71 Sec. 8 Twp. 12 R. 17W

Well No. 1 Drilling

Nadel & Gussman Company

FIRST REPORT

Contractor

NW NE


SECTION PLAT

330 Ft. from N. Line

_____ Ft. from S. Line

_____ Ft. from E. Line

330 Ft. from W. Line

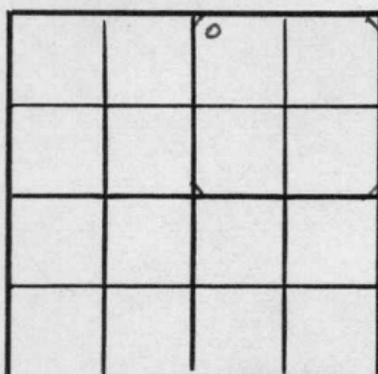

Ellis

Location _____

Rig up _____

Drilling and Remarks:

RUR

RECORD

Cased _____ in., _____ ft.

Sand _____

Gas _____

Oil _____

Total Depth _____

PRODUCTION

1st 24 hrs. Nat. _____

1st 24 hrs. after shot _____

Gas _____ Cu. Ft.

Dry Hole _____

Abandoned _____

Date

MAR 14 1945 19

S. J. LEWIS Scout

Pool Name Shutts

Map No. 571 Sec. 8 Twp. 12 R. 17W

Well No. 1 Drilling

Nadel & Gussman Company

ABANDONED

Contractor

NW NE

SECTION PLAT

330 Ft. from N. Line

_____ Ft. from S. Line

_____ Ft. from E. Line

330 Ft. from W. Line

		0	

Ellis County

Location _____

Rig up _____

Drilling and Remarks:

4 one 330-0

Coing 3587

RECORD

Cased _____ in., _____ ft.

Sand _____

Gas _____

Oil _____

Total Depth 3652

PRODUCTION

1st 24 hrs. Nat. _____

1st 24 hrs. after shot _____

Gas _____ Cu. Ft.

Dry Hole _____

Abandoned _____

Date

APR 4 1945 19

S. J. LEWIS Scout