

Map No. KANSAS Sec. 8 Twp. 12 R. 17

Well No. 1-Heider Farm
Phelps Per Company

NORTH

			0				

WEST

EAST

SOUTH

Location.....

Drilling Remarks

.....

.....

RECORD

Cased.....in.....ft.

Sand.....

Gas.....

Oil.....

Total Depth.....

Rig Up.....

Drilling Remarks

.....

.....

PRODUCTION

1st 24 hrs. Nat.....

1st 24 hrs. after shot.....

Gas.....cu. ft.....

Dry Hole.....

Abandoned.....


Map No. KANSAS Sec. 8 Twp. 12 R. 17^W
 Well No. 1- Huddle Farm
Phillips Pet Company

330 Ft. from N. Line

 Ft. from S. Line

330 Ft. from E. Line

 Ft. from W. Line

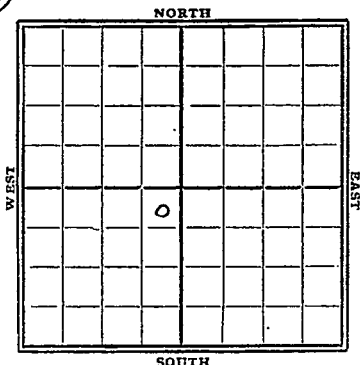

1929

Date	REPORT
1/16	Location
1/23	Bldg Rig
1/30	Rig
2/6	—
2/13	—
2/20	Spud
2/27	—
3/6	Spud 300'
3/13	Drilg 755'
3/20	" 1018'
3/27	" 1350'
4/3	" 1885'
4/10	" 2170
4/17	" 2655'
4/24	" 2955'
5/1	S.D. 2995
5/8	—
5/15	show Oil 3150-55
	" " 3497-3505
	urlg 3555'
5/22	log 6"-3642'
5/29	—

6/5 - f29 6" - 3642

6/12 - —

6/18 - 3644 - Cem. 6"

6/26 - Rig burned

Ribldg Rig

7/2 —

7/10 - Wrlg by tools 3690'

7/17 —

7/24 - S/R 6" - 3700'

7/31 - S.D. 3704'

8/7 - Wrlg 3726'

8/14 - " 4010'

8/21 abandoned

T.D. 4017'

MAP No. KANSAS SEC. 8 TWP. 12 R. 17W

WELL No. 1 Heider

Phillips P. & H. COMPANY

CONTRACTOR

SECTION PLAT

	0		

330 FT. FROM N. LINE

FT. FROM S. LINE

330 FT. FROM E. LINE

FT. FROM W. LINE

FIRST REPORTS

LOCATION ✓

RIG UP

DRILLING AND REMARKS:

RECORD

CASED IN. FT.

SAND

GAS

OIL

TOTAL DEPTH

PRODUCTION

1ST 24 HRS. NAT.

1ST 24 HRS. AFTER SHOT

GAS CU. FT.

DRY HOLE

ABANDONED

DATE

JAN 16 1929

192

S. J. LEWIS

SCOUT

Map No. **KANSAS** Sec. 8 Twp. 12 R. 17WWell No. 71 1 HeiderPhillips Petroleum Company

Contractor

SECTION PLAT

330 Ft. from N. Line

_____ Ft. from S. Line

330 Ft. from E. Line

_____ Ft. from W. Line

ABANDONED

		0	

Location _____

Rig up _____

Drilling and Remarks:

RECORD

Cased _____ in., _____ ft.

Sand _____

Gas _____

Oil _____

Total Depth 4017

PRODUCTION

1st 24 hrs. Nat. _____

1st 24 hrs. after shot _____

Gas _____ Cu. Ft.

Dry Hole _____

Abandoned _____

Date

AUG 21 1929S. J. LEWIS Scout