


DX 78-1

Ellis KANSAS

Section 8 Township 12 Range 17W

Well No. 2 Dreiling "B"

Company Carl Lebsack

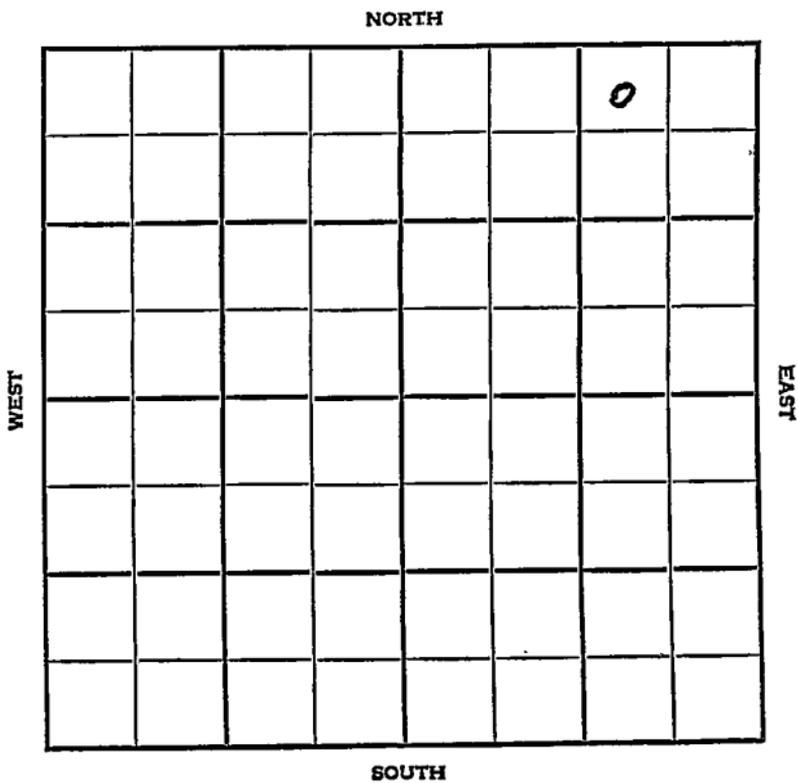

Ellis

KANSAS

SEC. 8	TWP. 12	R. 17W
-----------	------------	-----------


WELL NO. #2 Dreiling "B" FARM

COMPANY Carl Lebsack

CONTRACTOR Isern

Bemis-Shutts Pool

330 Ft. from N. Line
 Ft. from S. Line
 990 Ft. from E. Line
 Ft. from W. Line

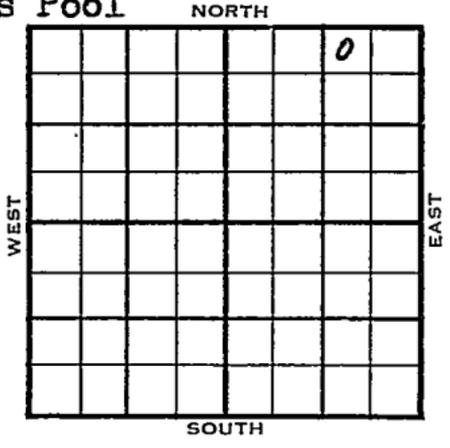

NW NE NE

1955	ELEVATION 2088'	REPORT
------	--------------------	--------

1/26

Spud 1-24-55
 Drlg. 150'

3/30

Spud 1-24-55
 Oil Well
 TD 3625'
 Lans 3313'
 DST 3342'-3415' opn 35 min, rec 20'
 Mud, 1010# Arb. 3577'
 DST 3580'-90' opn 1 hr, rec 25' Mud
 100#
 DST 3600'-25' opn 1 hr, rec 22'
 Mud, 5' ocm, 5' free oil, 960#
 TD 3625'
 5" @ 3624
 16/ 3608-12 300 A S/ 3 1/2 boph
 12 hr. P/ 2 boph
 Comp 25 bopd.

COMPLETED

County **Ellis** State **Kansas**

Sec. **8** (Blk. **12** (Sur. Rge.) **17W** Map No.

Operator **Carl Lebsack**

Well No. **2** Farm **Dreiling "B"**

Elev. _____ Location **NW NE NE**

330 Ft. From **N** Line **NE**
990 Ft. From **E** Line **Quarter**

Ist. Report **JAN 26 1955**

Completion _____

Remarks **Isern - Contr.**

Spudding Date **1-24-55**

Bemis-Shutts Pool

Drlg. Data
drlg. 150

