


Section **8** Township **12** Range **17W**

Well No. **#1 Schmeidler (B)**

Company **B & R Drlg. Co.**

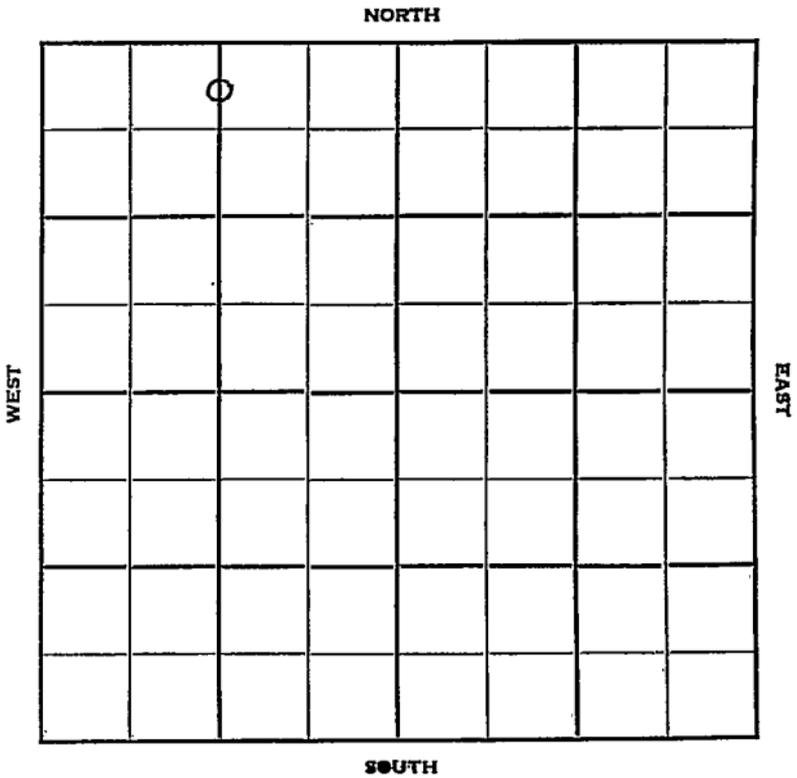

8

12

R. 17W

Sec. _____ Twp. _____ R. _____

Well No. #1 Schmeidler (B) _____ Farm

B & R Drlg. Co. _____ Company

B & R Drlg. _____ Contractor


330 Ft. from N. Line

_____ Ft. from S. Line

_____ Ft. from E. Line

1320 Ft. from W. Line

C N/2 N/2 NW

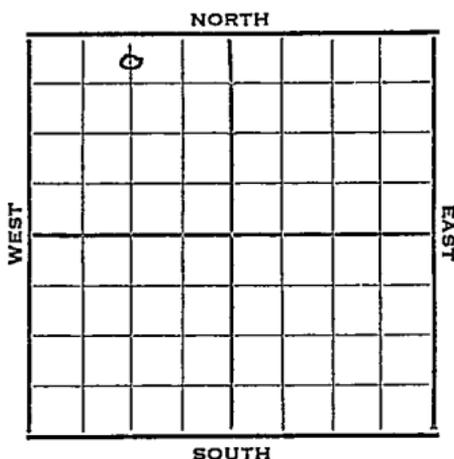

1952 Elev. 2136' REPORT

5/28 Spud 5-23-52
8" @ 207'
Anhy 1355'
Drlg. 1640'

6/11 Arb. 3633 RTD 3659
5" @ 3656'

6/18 MICT

6/25 CO 3660' 250 A S/30 gal OPH
1000 A S/28 BOPH POP

7/2 Simp 3623 Arb. 3633

7/9 NR

7/17 "

7/23 Spud 5-23-52
Oil Well TD 3659 8" @ 207
Anhy 1355 Lans. 3362 Arb. 3653
5" @ 3656 TD 3659 CO to 3660
250 A S/30 boph 1000 A S/28 boph
DST 3390-3470 opn 1½ hrs Rec. 850'
o & gcm 850# Simp 3623 Arb. 3633
Comp. 50 bopd

County **Ellis** State **Kansas**

Sec. **8** (Blk.) **12** (Sur.) **17W** (Twp.) **17W** Map No.

Operator **B & R Drilling Co.**

Well No. **1** Farm **Schmeidler (B)**

Elev. **2136** Location **C N/2 N/2 NW**

FIRST REPORT

350 Ft. From **N** Line **NW**

1320 Ft. From **W** Line. Quarter

Ist. Report **MAY 28 1952**

Completion

Remarks

B & R Drlg. * Contr.

Spudding Date **5-23-52**

Drlg. Data

8" @ 207 Anhy 1355 Drlg. 1640

J. G. McGEHEE

County Ellis State Kansas

Sec. 8 (Blk.) 12 (Sur. Rge.) 17W Map No.

Operator B & R Drlg.

Well No. 1 Farm Schmeidler "B"

Elev. 2136 Location C N L N $\frac{1}{2}$ NW

0					

330 Ft. From N Line NW
1320 Ft. From W Line Quarter

Ist. Report

Completion JUL 23 1952

Remarks

B & R Drlg. - Contr.

Spudding Date 5-23-52

Drlg. Data Oil well TD 3659

8" @ 207 Anhy 1355 Lans. 3362

Arb. 3653 5" @ 3656 TD 3659 CO to 3660

250 A S/ 30 goph 1000 A S/ 28 boph

DST 3390-3470 open 1 $\frac{1}{2}$ hr. Rec. 850!

o & gema 850# Simp. 3623 Arb. 3633

Comp. 50 bopd