


Section 8 Township 12 Range 17 W

Well No. # 2 Schmeidler "B"

Company Isern Drlg.

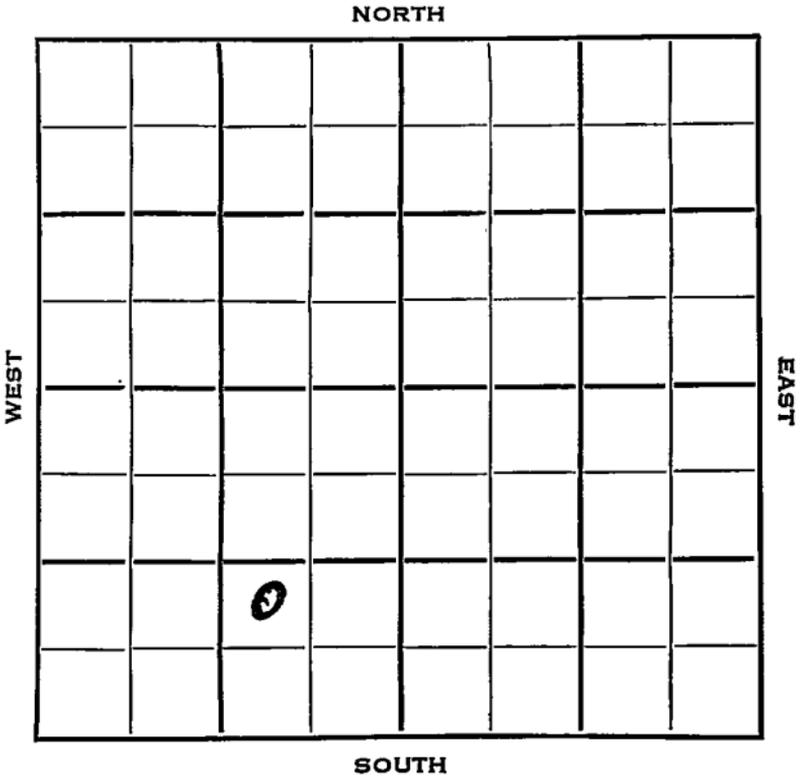

Ellis **KANSAS** ✓

Sec. 8 Twp. 12 R. 17W

Well No. #2 Schmeidler "B" Farm

Isern Drlg. Company

Contractor


           Ft. from N. Line

990 Ft. from S. Line

990 Ft. from E. Line

           Ft. from W. Line

NW SE SW

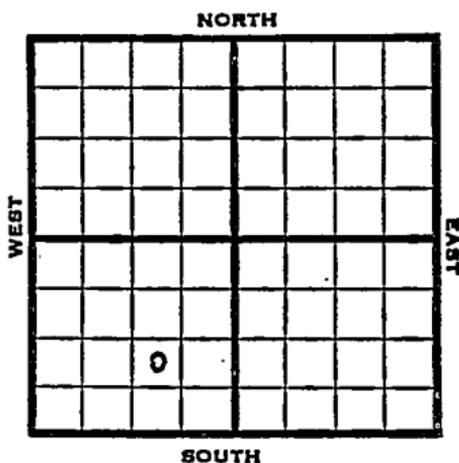

1952 Elev. 2142' REPORT

11/26 Spud 11-20-52  
8" @ 190  
Anhy 1365'  
Drlg. 2885'

12/4 NR

12/11 Heeb 3342 Lans 3389 Simp 3640  
Arb 3660 RTD 3666 5" @ 3664 C03666  
SSO DD

12/18 DD 3667 FW 1200' Oil 12 hrs.  
S/28 BO 24 Hrs. POP

12/25 " " "

1/1 NR

1/8 NR

1/23 Spud 11-20-52  
Oil Well  
TD 3667  
8" @ 190  
Anhy 1365, Heeb 3342, Lans 3389,  
Simp 3640, Arb. 3660  
TD 3666  
5" @ 3664, CO to 3666 SSSO  
DD 3667, FU 1200' oil 12 hrs.  
S/128 bo 24 hrs.  
Comp. 265 bopd **COMPLETED**



County Ellis State Kansas

Sec. 8 (Blk. 12) (Sur. 17W) Twp. (Rge.) Map No.

Operator Isern Drlg.

Well No. 2 Farm Schmeidler "B"

Elev. 2142 Location NW SE SW


**COMPLETE**

990 Ft. From S Line SW

990 Ft. From E Line Quarter

Ist. Report

Completion JAN 23 1953

Remarks

Spudding Date 11-20-52

Drlg. Data Oil well TD 3667

8" @ 190 Anhy 1365 Heeh. 3342

Lans. 3389 Simp. 3640 Arb. 3660

TD 3666 5" @ 3664 CO to 3666 SSO

DD 3667 FU 1200' oil 12 hr.

S/ 128 bo 24 hr. Comp. 265 bopd