


DX 78-1

Section 8 Township 12 Range 17W

Well No 3 Schmeidler

Company Isern Drlg.

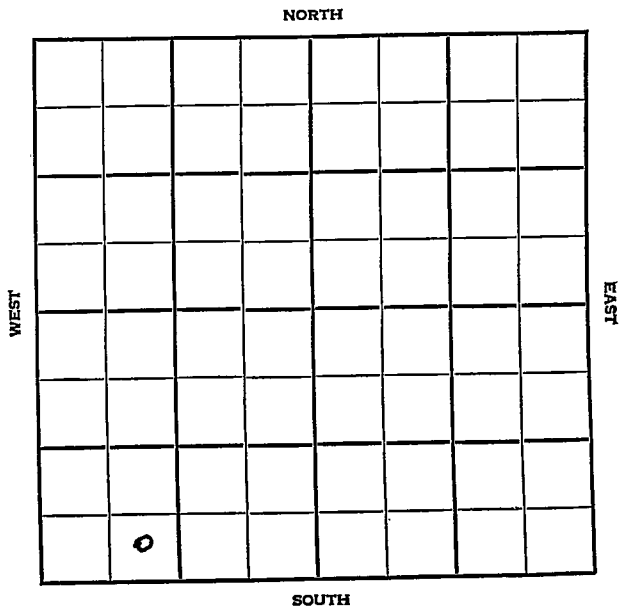

Ellis

KANSAS

SEC. 8	TWP. 12	R. 17W
-----------	------------	-----------


WELL NO. **3 Schmeidler** FARM

COMPANY **Isern Drlg**

CONTRACTOR

**Bemis Shutts Pool**

\_\_\_\_\_ Ft. from N. Line  
**330**  
 \_\_\_\_\_ Ft. from S. Line  
 \_\_\_\_\_ Ft. from E. Line  
**990**  
 \_\_\_\_\_ Ft. from W. Line

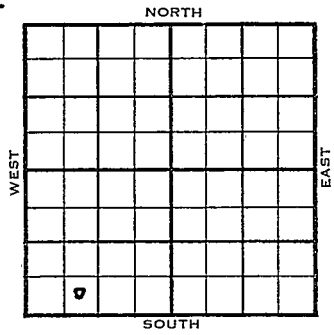

**SE SW SW**

1954	ELEVATION <b>2166</b>	REPORT
------	--------------------------	--------

6/8 Spudding 5-31-54  
 8" @ 175  
 Anhy 1387  
 Drlg. 3282

7/14 Spud 5-31-54 Oil well TD 3680  
 8" @ 175 Anhy 1387 Arb. 3678  
 TD 3680 5" @ 3673 CO to 3680  
 S/10 BOPH Comp. 385 BOPD

**COMPLETED**



