


DX 78-1 Ellis

Section 8 Township 12 Range 17W

Well No. 2 Schmeidler "E"

Company Trans-Era Pet.

NORTH

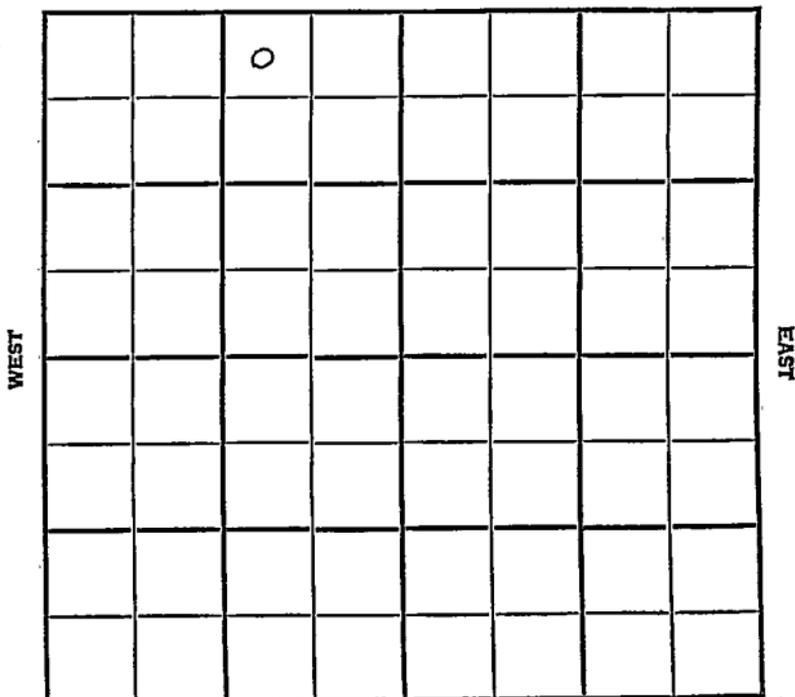

SOUTH

SEC.	TWP.	R.
8	12	17W


WELL NO. #2 Schmeidler "E" FARM

COMPANY Trans-Era Pet.

CONTRACTOR Co. Tools.

Bemis-Shutts Pool

330 Ft. from N. Line
 Ft. from S. Line
 990 Ft. from E. Line
 Ft. from W. Line

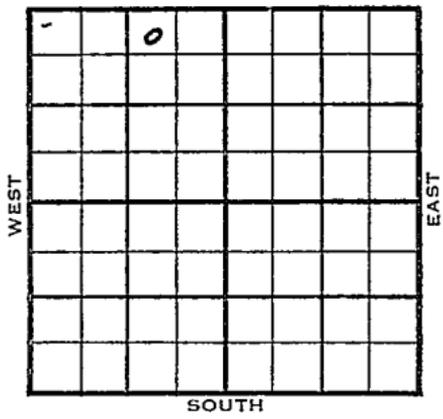

NW NE NW

1955	ELEVATION	REPORT
	2133'	

4/27
6/1

Location
 Comm 4-28-55
 8 5/8" @ 190/150 DST 3401-40 open
 1 hr Rec 120' Hocm, 120' gassy oil
 800/20", DST 3440-60, open 1 hr
 Rec 60' 0 & gcm 60' mud & wtr
 980/20" DST 3464-92' open 1 hr,
 Rec 10' mud 0/20" DST 3613-40
 open 1 hr Rec 7' mud 0/20"
 5" @ 3639/100 DD 3644 500 A
 B/14 goph 1250 A S/8 boph 6 hr
 Comp 50 bopd


 H 3307, L. 3352, A 3617
 TD 3640

COMPLETED

County Ellis Elev. 2133
 Sec. 8 Twp. 12 Rge. 17W
 Company Trans-Era Pet.
 Farm Name Schmeidler "E" No. 2

TOPS	DEPTH	LOG	DATUM
Anh.			
Tp.			
H.	3307		1174
Tr.			
Dg.			
Bl.			
L.	3352		1219
K.C.			
B.K.C.			
Ce.			
C.			
M.			
M.			
K.			
Mz.			
Me.			
V.			
S.			
S.			
A	3617		1484
R.			
PE.			
G.			
T.D.	3640		

Loc. in Sec. NW NE NW
 Geol. _____
 Contr. _____
 Pool _____
 Bemis-Shutts

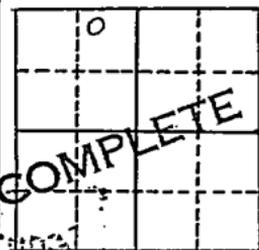

Date Comm. 4-28-55 JUN. 1 1955
8 5/8" @ 190/150 DST 3401-40 open 1 hr
Rec. 120' hocom. 120' gassy oil 800/20"
DST 3440-60 open 1 hr. Rec. 60' o & gcm
60' mud & wtr. 980/20" DST 3464-92
open 1 hr. Rec. 10' mud 0/20"
DST 3613-40 open 1 hr. Rec. 7' mud
0/20" 5" @ 3639/100 DD 3644 500 A
B/ 14 goph 1250A S/ 8 boph 6 hr.
Comp. 50 bopd

Co.
 Lse.
 No.
 Sec.
 T.
 R.