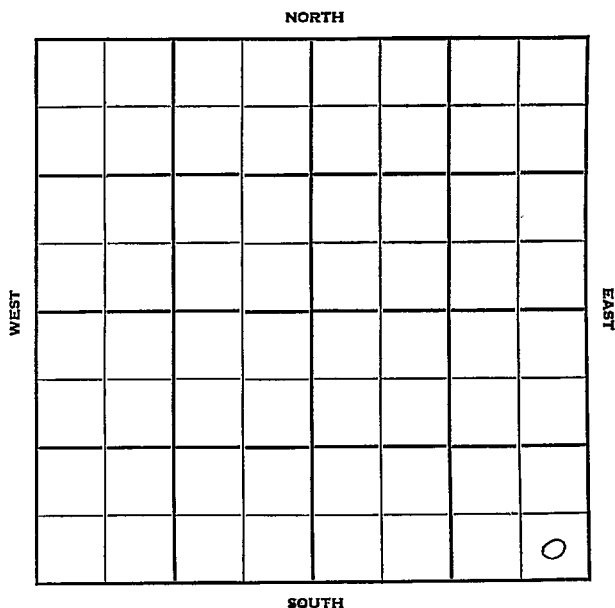


Section 9 Township 12 Range 17WWell No. #1 RohlederCompany Glickman Oil

Ellis KANSAS

Sec. 9 Twp. 12 R. 17 W

Well No. # 1 Rohleder Farm

Glickman Oil Company

Veeder Contractor

Wildcat

 Ft. from N. Line


330 Ft. from S. Line

330 Ft. from E. Line

 Ft. from W. Line

SE SE SE

Phillips & Amerada DHM

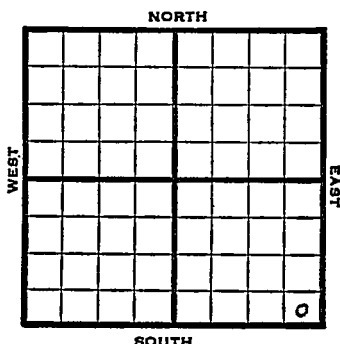

1952

Elev. 2147'

REPORT

1/30

Spud 1-26-52

8" @ 190

Anhy 1368'

Drlg. 1372'

2/6

Anhy 3114

Heeb. 3365

Lans. 3412

Drlg. 3580'

2/13

Spud 1-26-52

D&A TD 3756

8" @ 190

Anhy 1368

Top. 3114

Heeb. 3365

Lans. 3412


Cong. 3659

Arb. 3718

TD 3756

D&A

ABANDONED

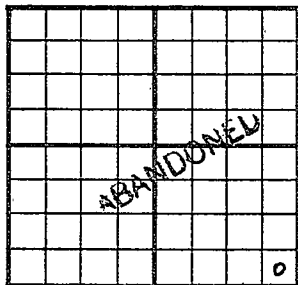County Ellis State KansasSec. 9 (Blk. Twp.) 12 (Sur. Rge.) 17W Map No.Operator Glickman OilWell No. 1 Farm RohlederElev. 2147 Location SE SE SE330 Ft. From S Line SE330 Ft. From E Line Quarter

1st. Report

Completion FEB 13 1952Remarks WildcatVeeder - Contr.Spudding Date 1-26-52Drlg. Data D & A TD 37568" @ 190 Anhy 1368 Top. 3114Heeb. 3365 Lans. 3412 Cong. 3659Arb. 3718 TD 3756D & A