


Section 9 Township 12 Range 17-W

Well No. #1 Dreiling

Company Westgate-Greenland
Bemis

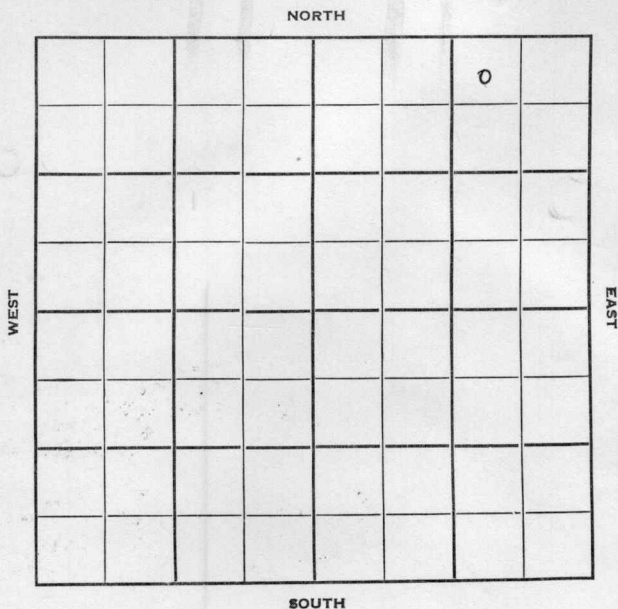

Ellis

KANSAS

Sec. 9 Twp. 12 R. 17W

Well No. #1 Dreiling Farm

Westgate-Greenland Company

Jackson Contractor

Bemis Pool


330' Ft. from N. Line

Ft. from S. Line

990' Ft. from E. Line

Ft. from W. Line

NW NE NE

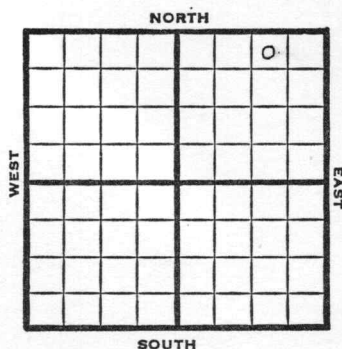

1950 Elev. 2127' REPORT

3/8 Spud 3-2-50
8" @ 166'
Anhy 1345-85'
Drlg 2360'

3/15 TD 3684'
8"@ 166'
Heeb 3320'
Lans 3360'
Arb. 3632'
D&A
Aband.

ABANDONED

Kansas

Bemis Pool

Map No. _____ Sec. 9 Twp. 12 R. 17WWell No. 1 DreilingWestgate-Greenland CompanyJackson Contractor

NW NE NE

El. 2127

SECTION PLAT

330 Ft. from N. Line Ft. from S. Line990 Ft. from E. Line Ft. from W. LineEllis County

Location _____

Rig up _____

Drilling and Remarks:

Spud 3-2-50

8" @ 166

Anhy 1345-85

drlg. 2360

RECORD

Cased _____ in., _____ ft.

Sand _____

Gas _____

Oil _____

Total Depth _____

PRODUCTION

1st 24 hrs. Nat. _____

1st 24 hrs. after shot _____

Gas _____ Cu. Ft.

Dry Hole _____

Abandoned _____

Date

MAR 8 1950 19J. E. TYRA

Scout

Map No. _____ Sec. ^{Kansas} 9 Twp. 12 R. 17W

Well No. 1 Dreiling

Westgate-Greenland Company

Contractor

NW NE NE

E/ 2127
SECTION PLAT



330 Ft. from N. Line

Ft. from S. Line

990 Ft. from E. Line

Ft. from W. Line

Ellis County

Location _____

Rig up _____

Drilling and Remarks:

8' @ 166
Hub 3320
Lans 3360
and 3632
D & A

RECORD

Cased _____ in., _____ ft.

Sand _____

Gas _____

Oil _____

Total Depth 3684

PRODUCTION

1st 24 hrs. Nat. _____

1st 24 hrs. after shot _____

Gas _____ Cu. Ft.

Dry Hole _____

Abandoned _____

Date

MAR 15 1950

J. E. TYRA

19

Scout