


STATE OF KANSAS  
STATE CORPORATION COMMISSION

Give All Information Completely  
Make Required Affidavit  
Mail or Deliver Report to:  
Conservation Division  
State Corporation Commission  
211 No. Broadway  
Wichita, Kansas

State Geological Survey Form CP-4  
WICHITA BRANCH  
WELL PLUGGING RECORD  
25-13-14W

NORTH

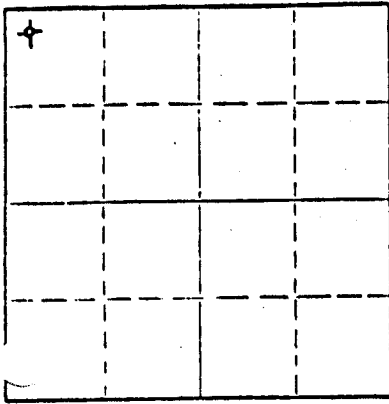

Locate well correctly on above Section Plat

Russell County, Sec. 25 Twp. 13 Rge. 14 (E) W (W)  
Location as "NE/CNW&SW&" or footage from lines NW NW NW  
Lease Owner Shields Oil Producers, Inc.  
Lease Name Krug Well No. 1  
Office Address Shields Building, Russell, Kansas  
Character of Well (completed as Oil, Gas or Dry Hole) Dry hole  
Date well completed June 19 19 63  
Application for plugging filed June 19 19 63  
Application for plugging approved June 19 19 63  
Plugging commenced June 19 19 63  
Plugging completed June 19 19 63  
Reason for abandonment of well or producing formation Dry hole

If a producing well is abandoned, date of last production 19  
Was permission obtained from the Conservation Division or its agents before plugging was commenced? Yes

Name of Conservation Agent who supervised plugging of this well Donald Truan  
Producing formation Depth to top Bottom Total Depth of Well 3,320 Feet  
depth and thickness of all water, oil and gas formations.

OIL, GAS OR WATER RECORDS

CASING RECORD

FORMATION	CONTENT	FROM	TO	SIZE	PUT IN	PULLED OUT
				8 5/8"	225'	Cmtd. w/175 sax

Describe in detail the manner in which the well was plugged, indicating where the mud fluid was placed and the method or methods used in introducing it into the hole. If cement or other plugs were used, state the character of same and depth placed, from feet to feet for each plug set.

Fill w/heavy mud to 220'

Set bridge plug @220' w/1/4 sax hulls on plug

Dump 25 sax cement on plug thru 4 1/2" drill pipe

Fill w/heavy mud to 40'

Set bridge plug @40' w/ 1/2sax hulls on plug

Dump 10 sax cement on plug to cellar

STATE CORPORATION COMMISSION

JUL 1 1963

CONSERVATION DIVISION  
Wichita, Kansas

(If additional description is necessary, use BACK of this sheet)

Name of Plugging Contractor Shields Drilling Co., Inc.  
Address Shields Building, Russell, Kansas

STATE OF Kansas COUNTY OF Russell, ss.  
R. L. Shields

(owner or operator) of the above-described well, being first duly sworn on oath, says: That I have knowledge of the facts, statements, and matters herein contained and the log of the above-described well as filed and that the same are true and correct. So help me God.

(Signature) R. L. Shields

Shields Building, Russell, Kansas  
(Address)

SUBSCRIBED AND SWORN TO before me this 28th day of June, 19 63

My commission expires November 9, 1963

Notary Public