

PI  
*[Handwritten signature]*

STATE CORPORATION COMMISSION OF KANSAS  
OIL & GAS CONSERVATION DIVISION

WELL COMPLETION OR RECOMPLETION FORM  
ACO-1 WELL HISTORY

DESCRIPTION OF WELL AND LEASE

Operator: license # 5109  
name Aylward Drilling Company  
address 909 First National Bank Bldg  
City/State/Zip Wichita, Kansas 67202

Operator Contact Person Frank Hamlin  
Phone (316) 265-6656

Contractor: license # 5122  
name Woodman-Iannitti Drilling Company

Wellsite Geologist Kenneth Hamlin  
Phone (316) 684-6999

Designate Type of Completion  
 New Well  Re-Entry  Workover

Oil  SWD  Temp Abd  
Gas  Inj  Delayed Comp.  
 Dry  Other (Core, Water Supply etc.)

If OWWO: old well info as follows:  
Operator  
Well Name  
Comp. Date Old Total Depth

WELL HISTORY

Drilling Method:  Mud Rotary  Air Rotary  Cable  
7/26/84 8/2/84 8/2/84  
Date Date Reached TD Completion Date

3320'  
Total Depth PBD

Amount of Surface Pipe Set and Cemented at 256' feet

Multiple Stage Cementing Collar Used?  Yes  No

If Yes, Show Depth Set feet

If alternate 2 completion, cement circulated  
from 0 feet depth to 256' w/ 150 SX cmt

API NO. 15-167-22,431

County Russell

SE SW SW 31 13 14W  
(location) Sec Twp Rge

...330!.. Ft North from Southeast Corner of Secti  
..4290!.. Ft West from Southeast Corner of Secti  
(Note: locate well in section plat below)


Lease Name Frank Smith Well# 1

Field Name Gorham Field

Producing Formation None

Elevation: Ground 1867 KB 1871

Section Plat

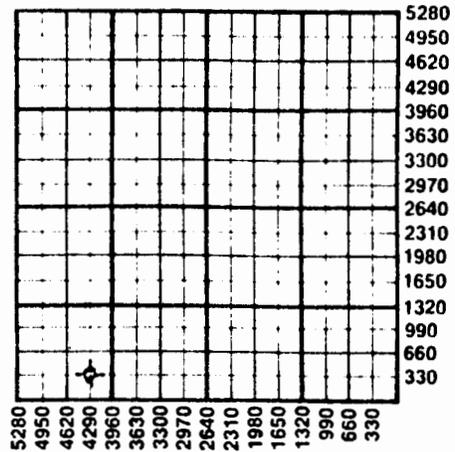

\* WATER SUPPLY INFORMATION

Source of Water:  
Division of Water Resources Permit #

Groundwater Ft North From Southeast Corner a  
(Well) Ft. West From Southeast Corner  
Sec Twp Rge  East  West

Surface Water Ft North From Southeast Corner a  
(Stream, Pond etc.) Ft West From Southeast Cor  
Sec Twp Rge  East  West

Other (explain)  
(purchased from city, R.W.D.#)

Disposition of Produced Water:  Disposal  Repressuring

Docket #

INSTRUCTIONS: This form shall be completed in duplicate and filed with the Kansas Corporation Commission, 200 Colorado Derby Building  
Wichita, Kansas 67202, within 90 days after completion or recompletion of any well. Rules 82-3-130 and 82-3-107 apply.

Information on side two of this form will be held confidential for a period of 12 months if requested in writing and submitted with the form. See rule 82-3-107  
for confidentiality in excess of 12 months.

One copy of all wireline logs and drillers time log shall be attached with this form. Submit CP-4 form with all plugged wells. Submit CP-111 form with  
all temporarily abandoned wells.

AUG 22 1984

