


STATE OF KANSAS
STATE CORPORATION COMMISSION

Give All Information Completely
Make Required Affidavit
Mail or Deliver Report to:
Conservation Division
State Corporation Commission
212 No. Market
Wichita, Kansas 67202

WELL PLUGGING RECORD

25-13-14W Form CP-4

NORTH

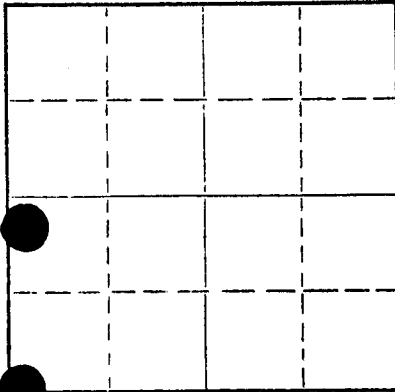

Locate well correctly on above
Section Plat

Russell County. Sec. 25 Twp. 13S Rge. (E) 14 (W)
Location as "NE/CNW/SW" or footage from lines NW NW NW
Lease Owner Zetco Petroleum Inc.
Lease Name Krug Wash Down Well No. 1
Office Address 357 Lulu - Wichita, Kansas
Character of Well (completed as Oil, Gas or Dry Hole) Dry
Date well completed 3-21 19 72
Application for plugging filed 3-21 19 72
Application for plugging approved 3-21 19 72
Plugging commenced 9:45 3-21 19 72
Plugging completed 12:45 3-21 19 72
Reason for abandonment of well or producing formation dry

If a producing well is abandoned, date of last production 19
Was permission obtained from the Conservation Division or its agents before plugging was commenced? yes

Name of Conservation Agent who supervised plugging of this well Leo Massey
Producing formation Depth to top Bottom Total Depth of Well 856 Feet
Show depth and thickness of all water, oil and gas formations.

OIL, GAS OR WATER RECORDS

CASING RECORD

FORMATION	CONTENT	FROM	TO	SIZE	PUT IN	PULLED OUT
Soil & clay		0			0	0

Describe in detail the manner in which the well was plugged, indicating where the mud fluid was placed and the method or methods used in introducing it into the hole. If cement or other plugs were used, state the character of same and depth placed, from feet to feet for each plug set.

Plug hole 1st plug 500' w/40 sx 2nd plug 6 220' w/25 sx
top plug 40'-0" w/ 10 sx

(If additional description is necessary, use BACK of this sheet)

Name of Plugging Contractor B & B Drilling, Inc.
Address 720 Union Center - Wichita, Kansas