


Give All Information Completely  
Make Required Affidavit  
Mail or Deliver Report to:  
Conservation Division  
State Corporation Commission  
212 North Market, Insurance Bldg.  
Wichita, Kansas

WELL PLUGGING RECORD

Russell County, Sec. 33 Twp. 13 Rgs. 15 (X) (W)

Location as "NE/CNWxSWx" or footage from lines SE NW SE  
Lease Owner Icer Addis  
Lease Name Mills Well No. B-8  
Office Address Great Bend, Kansas  
Character of Well (completed as Oil, Gas or Dry Hole) Dry Hole  
Date well completed September 17 19 64  
Application for plugging filed September 17 19 64  
Application for plugging approved September 17 19 64  
Plugging commenced September 17 19 64  
Plugging completed September 17 19 64  
Reason for abandonment of well or producing formation Dry Hole

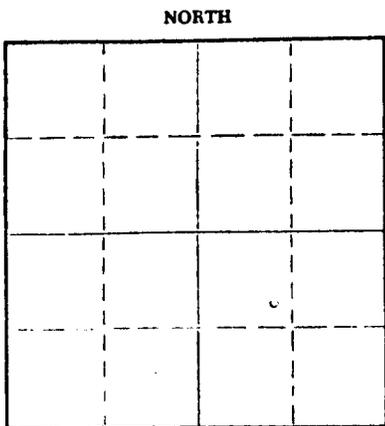

Locate well correctly on above Section Plat

If a producing well is abandoned, date of last production 19  
Was permission obtained from the Conservation Division or its agents before plugging was commenced? Yes

Name of Conservation Agent who supervised plugging of this well Don Toman  
Producing formation \_\_\_\_\_ Depth to top \_\_\_\_\_ Bottom \_\_\_\_\_ Total Depth of Well \_\_\_\_\_ Feet  
Show depth and thickness of all water, oil and gas formations.

OIL, GAS OR WATER RECORDS

CASING RECORD

FORMATION	CONTENT	FROM	TO	SIZE	PUT IN	PULLED OUT

Describe in detail the manner in which the well was plugged, indicating where the mud fluid was placed and the method or methods used in introducing it into the hole. If cement or other plugs were used, state the character of same and depth placed, from \_\_\_\_\_ feet to \_\_\_\_\_ feet for each plug set.

Filled hole with heavy mud to 900' and set plug and hulls and 10 sacks of cement through drill pipe.

Filled hole with heavy mud to 500' and set plug and hulls and 2 sacks cement through drill pipe.

Filled hole with heavy mud to 40' and set plug and hulls and 10 sacks cement.

Put 2 sacks cement in rat hole.

(If additional description is necessary, use BACK of this sheet)

Name of Plugging Contractor Burt Drilling Co.  
Address Great Bend, Kansas

33-13-15W

STATE OF KANSAS  
STATE CORPORATION COMMISSION  
CONSERVATION DIVISION  
500 INSURANCE BUILDING  
212 NORTH MARKET  
WICHITA 2, KANSAS

WELL PLUGGING APPLICATION FORM  
File One Copy

Lease Owner ICER ADDIS  
(Applicant)  
Address Great Bend, Kansas

Lease (Farm Name) Mills Well No. B-8

Location SE NW SE Sec. 33 Twp. 13 Rge. 15 (X) (W)

County Russell Field Name (If any) \_\_\_\_\_

Total Depth 3324 Oil Well \_\_\_\_\_ Gas Well \_\_\_\_\_ Input Well \_\_\_\_\_ SWD Well \_\_\_\_\_ D & A X

Was well log filed with application? Yes If not, explain: \_\_\_\_\_

Date and hour plugging is desired to begin September 17, 1964 9:00 A.M.

Plugging of the well will be done in accordance with the Rules and Regulations of the State Corporation Commission. Yes

Name of the person on the lease in charge of well owner Francis Zink

Address Ellinwood, Kansas

Drilling Contractor Burt Drilling Co. License No. \_\_\_\_\_

Address Great Bend, Kansas

Office covering assessment for plugging this well should be sent to Icer Addis

Address Great Bend, Kansas

and payment will be guaranteed by applicant.

BURT DRILLING CO.

Signed: [Signature]  
Applicant or Acting Agent

KANSAS GEOLOGICAL SURVEY  
WICHITA BRANCH

SEP 22 1964

Date: October 28, 1964