

County **Russell** State **Kansas**  
 Sec. **34** (Blk.) **13** (Sur.) **15** (Twp.) **15** Map No.  
 Operator **Sohio Oil**  
 Well No. **3** Farm **Mills "A"**  
 Elev. **1896** Location **C N L SW SW**

1	2	3	4
5	6	7	8
9	10	11	12
13	14	15	16
17	18	19	20
21	22	23	24
25	26	27	28
29	30	31	32
33	34	35	36

*Handwritten in grid: FIRST REPORT, AMANG... (partially obscured), and other illegible marks.*

**990** Ft. From **S** Line **SW**  
**660** Ft. From **W** Line **Quarter**  
 Ist. Report  
 Completion **JUN 27 1951**  
 Remarks **Gorham Pool**  
 Spudding Date **6-13-51**

Drig. Data **D & A** **TD 3345**  
**8" @ 313** Anhy **975** Top. **2785**  
 Heeb. **3007** Lans. **3058** DST **3150-58**  
 open **1 hr.** Rec. **40'** mud & sw **5'** socm  
 Gorham sd. **3327** DST **3326-29** open **90 min.**  
 Rec. **90'** water Arb. **3329** TD **3345**  
**D & A**

J. E. TYRA

County **Russell** State **Kansas**  
 Sec. **34** (Blk.) **13** (Sur.) **15** (Twp.) **15** Map No.  
 Operator **Sohio Oil**  
 Well No. **3** Farm **Mills (A)**  
 Elev. Location **C N/2 SW SW**

1	2	3	4
5	6	7	8
9	10	11	12
13	14	15	16
17	18	19	20
21	22	23	24
25	26	27	28
29	30	31	32
33	34	35	36

*Handwritten in grid: FIRST REPORT, AMANG... (partially obscured), and other illegible marks.*

**990** Ft. From **S** Line **SW**  
**660** Ft. From **W** Line **Quarter**  
 Ist. Report **JUN 27 1951**  
 Completion  
 Remarks  
 Spudding Date **6-13-51**

Drig. Data **Gorham Pool**  
**8" @ 313** anhy **975'** Top **2785** Hub **3007**  
 Lans **3058** DST **3150-58** **1 hr. 40'** m plus **sw**  
 plus **5' Socm** Gorham sd. **3327** DST **3326-**  
**29** **90 min.** **-90'W** Arb **3329** **RTD 3345** **D&A**

J. E. TYRA


County **Russell** State **Kansas**

Sec. **34** (Bk. **16** Twp.) **13** (Sur. **12W** Rge.) **15** Map No.

Operator **Sohio Oil**

Well No. **5** Farm **Mills (A)**

Elev. \_\_\_\_\_ Location **C N/2 SW SW**

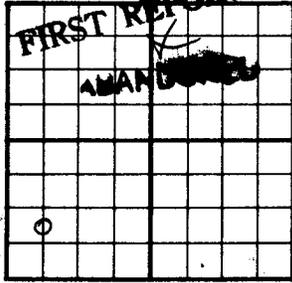

**990** Ft. From **S** Line **SW**

**660** Ft. From **W** Line Quarter

1st. Report **JUN 27 1951**

Completion \_\_\_\_\_

Remarks \_\_\_\_\_

Spudding Date **6-13-51**

Drig. Data **Gorham Pool**

**8" @ 313 anhy 975' Top 2785 Hub 3007**

**Lans 3058 DST 3150-58 1 hr. 40' m plus sw**

**plus 5' Socm Gorham sd. 3327 DST 3326-**

**29 90 min. -90°W Arb 3329 RTD 3345 D&A**

**U. E. TYRA**


County **Russell** State **Kansas**

Sec. **34** (Bk. **13** Twp.) **35** (Sur. **12W** Rge.) **15** Map No.

Operator **Sohio Oil**

Well No. **3** Farm **Mills "A"**

Elev. **1896** Location **C N L SW SW**

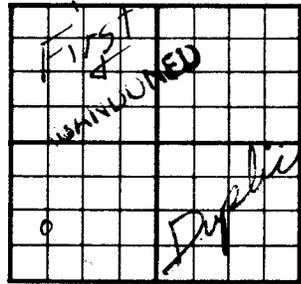

**990** Ft. From **S** Line **SW**

**660** Ft. From **W** Line Quarter

1st. Report \_\_\_\_\_

Completion **JUN 27 1951**

Remarks **Gorham Pool**

Spudding Date **6-13-51**

Drig. Data **D & A TD 3345**

**8" @ 313 Anhy 975 Top. 2785**

**Heeb. 3007 Lans. 3058 DST 3150-58**

**open 1 hr. Rec. 40' mud & sw 5' socm**

**Gorham sd. 3327 DST 3326-29 open 90 min.**

**Rec. 90' water Arb. 3329 TD 3345**

**D & A**

**J. E. TYRA**

Russell


Well No. #3 Mills "A" Farm \_\_\_\_\_

Sohio Oil Company \_\_\_\_\_

Contractor \_\_\_\_\_

Gorham Pool


Ft. from N. Line

990' Ft. from S. Line

Ft. from E. Line

660' Ft. from W. Line

C N L SW SW

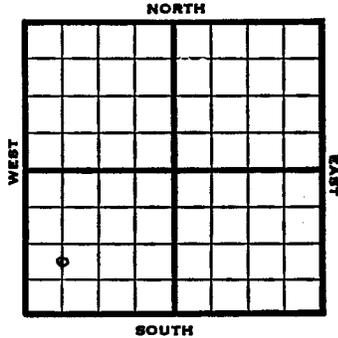


Section 34 Township 25 ~~13~~ Range 15 ~~23~~ ~~W~~

Well No. # 3 Mills "A"

Company Sohio Oil

NORTH

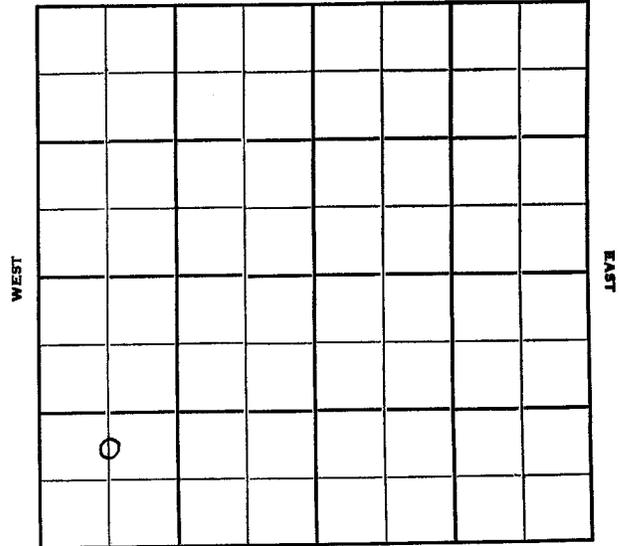

SOUTH

1951 Elev. 1896' REPORT

6/27 Spud 6-13-51  
 D&A TD 3345  
 8" @ 313  
 Anhy 975 Top. 2785  
 Heeb. 3007 Lans. 3058  
 DST 3150-53 opn 1 hr  
 "ec. 40' mud & sw 5' socm  
 Gorham sd 3327  
 DST 3326-29 opn 90 min  
 Rec. 90' wtr Arb. 3329  
 TD 3345  
 D&A

FIRST REPORT  
ABANDONED