

Ch 1881 RB


STATE OF KANSAS
STATE CORPORATION COMMISSION

WELL PLUGGING RECORD

Give All Information Completely
Make Required Affidavit
Mail or Deliver Report to
Conservation Division
State Corporation Comm.
245 North Water
Wichita, KS 67202

Russell County. Sec. 19 Twp. 13 Rge. 15 E/W
Location as "NE/CNW $\frac{1}{4}$ SW $\frac{1}{4}$ " or footage from lines
C NE SE

Lease Owner V. Francis Weigel
Lease Name Polcyn "D" Well No. 1
Office Address Box 244, Gorham, Kansas 67640
Character of Well (Completed as Oil, Gas or Dry Hole)

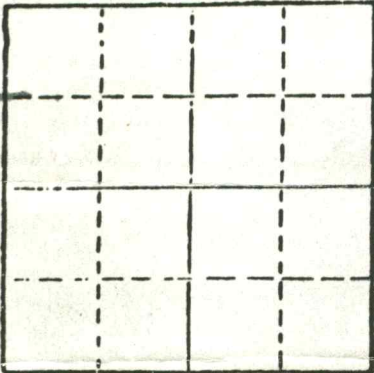

● Locate well correctly on above Section Plot

Dry Hole
Date Well completed 9-13 1979
Application for plugging filed " 1979
Application for plugging approved " 1979
Plugging commenced " 1979
Plugging completed " 1979
Reason for abandonment of well or producing formation

Dry Hole
If a producing well is abandoned, date of last production 19

Was permission obtained from the Conservation Division or its agents before plugging was commenced? Yes

Name of Conservation Agent who supervised plugging of this well Duane Rankin
Producing formation _____ Depth to top _____ Bottom _____ Total Depth of Well 3,315
Show depth and thickness of all water, oil and gas formations.

OIL, GAS OR WATER RECORDS

CASING RECORD

FORMATION	CONTENT	FROM	TO	SIZE	PUT IN	PULLED OUT
				8 5/8"	765'	Cmtd w/350 sax

Describe in detail the manner in which the well was plugged, indicating where the mud fluid was placed and the method or methods used in introducing it into the hold. If cement or other plugs were used, state the character of same and depth placed, from _____ feet to _____ feet for each plug set.

- Fill hole w/heavy mud
- Push bridge plug to 770'
- Spot 20 sax cement on plug thru 4 1/2" drill pipe
- Dump 2 sax cement in rat hole
- Dump 2 sax cement in mouse hole

(If additional description is necessary, use BACK of this sheet)

Name of Plugging Contractor Shields Drilling Co., Inc.
Shields Bldg., Russell, Kansas

STATE OF Kansas COUNTY OF Russell, ss contractor
R. L. Shields (employee of owner) or (owner or operator)

I, the above-described well, being first duly sworn on oath, says: That I have knowledge of the facts, statements, and matters herein contained and the log of the above-described well as filed and that the same are true and correct. So help me God.

(Signature) R. L. Shields
Shields Bldg., Russell, Kansas
(Address)

SUBSCRIBED AND SWORN TO before me this 25th day of October, 1979

Ruth Phillips
Notary Public.

My commission expires

