

Ind.

STATE CORPORATION COMMISSION OF KANSAS
OIL & GAS CONSERVATION DIVISION
WELL COMPLETION OR RECOMPLETION FORM
ACO-1 WELL HISTORY
DESCRIPTION OF WELL AND LEASE

Operator: License # 5145
Name Drilling Oil, Inc.
Address Box 1000
City/State/Zip ..Victoria, KS..67671

Purchaser The Permian Corp.
Houston, TX

Operator Contact Person Bill Draper
Phone (913) 735-2204

Contractor: License # 5145
Name Drilling Oil, Inc.

Wellsite Geologist Todd Dreiling
Phone (913) 625-3934

Designate Type of Completion

New Well Re-Entry Workover
 Oil SWD Temp Abd.
 Gas Inj Delayed Comp.
 Dry Other (Core, Water Supply etc.)

If OWWO: old well info as follows:

Operator
Well Name
Comp. Date Old Total Depth.....

WELL HISTORY

Drilling Method:

Mud Rotary Air Rotary Cable

7-11-87 7-17-87 9-10-87
Spud Date Date Reached TD Completion Date

3550'
Total Depth PBD

Amount of Surface Pipe Set and Cemented at 206 feet
Multiple Stage Cementing Collar Used? Yes No
If yes, show depth set.....feet
If alternate 2 completion, cement circulated
from.....feet depth to.....w/.....SX cmt
Cement Company Name
Invoice #

API NO. 15-051-24,494
County Ellis
SW SW SW Sec 2 Twp 13 Rge 16 East
X West

330 Ft North from Southeast Corner of Section
4950 Ft West from Southeast Corner of Section
(Note: Locate well in section plat below)


Lease Name Boxberger Well # 6

Field Name Seitz

Producing Formation Lansing-KC

Elevation: Ground 1969' 1974'
KB

Section Plat

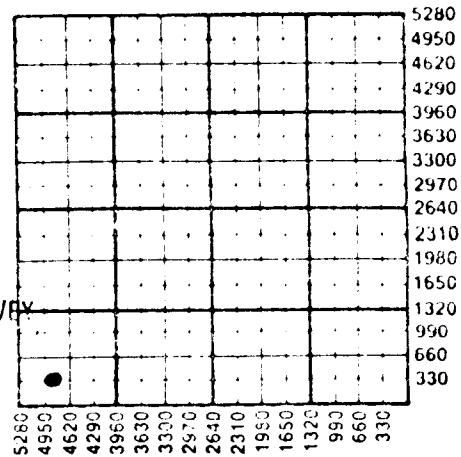

KANSAS GEOLOGICAL SURVEY
WICHITA BRANCH
SEP 21 1987

WATER SUPPLY INFORMATION

Disposition of Produced Water: Disposal
Docket # Repressuring

Questions on this portion of the ACO-1 call:

Water Resources Board (913) 296-3717

Source of Water:
Division of Water Resources Permit #.....

Groundwater.....Ft North from Southeast Corner
(Well)Ft West from Southeast Corner of
Sec Twp Rge East West

Surface Water.....Ft North from Southeast Corner
(Stream, pond etc).....Ft West from Southeast Corner
Sec 2 Twp 13 Rge 16 East West

Other (explain).....
(purchased from city, R.W.D. #)

INSTRUCTIONS: This form shall be completed in duplicate and filed with the Kansas Corporation Commission, 200 Colorado Derby Building, Wichita, Kansas 67202, within 90 days after completion or recompletion of any well. Rule 82-3-130 and 82-3-107 apply.

Information on side two of this form will be held confidential for a period of 12 months if requested in writing and submitted with the form. See rule 82-3-107 for confidentiality in excess of 12 months. One copy of all wireline logs and drillers time log shall be attached with this form. Submit CP-4 form with all plugged wells. Submit CP-111 form with all temporarily abandoned wells.

SIDE TWO

Operator Name Dreiling Oil, Inc. Lease Name Boxberger Well # 6

Sec. 2 Twp. 13 Rge. 16 East West County Ellis

WELL LOG

INSTRUCTIONS: Show important tops and base of formations penetrated. Detail all cores. Report all drill stem tests giving interval tested, time tool open and closed, flowing and shut-in pressures, whether shut-in pressure reached static level, hydrostatic pressures, bottom hole temperature, fluid recovery, and flow rates if gas to surface during test. Attach extra sheet if more space is needed. Attach copy of log.

| Drill Stem Tests Taken <input type="checkbox"/> Yes <input checked="" type="checkbox"/> No Samples Sent to Geological Survey <input type="checkbox"/> Yes <input checked="" type="checkbox"/> No Cores Taken <input type="checkbox"/> Yes <input checked="" type="checkbox"/> No | Formation Description <input checked="" type="checkbox"/> Log <input type="checkbox"/> Sample | | | | | | | | | | | | | | | | | | | | | | | | | | | | | | | | | |
|--|---|-------|----------|---------------|---------|--------|---------------|---------|-----------------------------------|---------|-----|----------|-------|--|--|-------------|-------|--|--|-------------|-------|--|--|-------------|-------|--|--|---------|-------|--|--|----------|-------|--|
| <table border="1" style="width:100%; border-collapse: collapse;"> <thead> <tr> <th style="width:60%;"></th> <th style="width:15%;">Name</th> <th style="width:15%;">Top</th> <th style="width:10%;">Bottom</th> </tr> </thead> <tbody> <tr><td></td><td>Anhy.</td><td>1098'</td><td></td></tr> <tr><td></td><td>Topeka</td><td>2932'</td><td></td></tr> <tr><td></td><td>Heebner Sh.</td><td>3148'</td><td></td></tr> <tr><td></td><td>Toronto Ls.</td><td>3172'</td><td></td></tr> <tr><td></td><td>Lansing -KC</td><td>3199'</td><td></td></tr> <tr><td></td><td>Base KC</td><td>3428'</td><td></td></tr> <tr><td></td><td>Arbuckle</td><td>3482'</td><td></td></tr> </tbody> </table> | | | | Name | Top | Bottom | | Anhy. | 1098' | | | Topeka | 2932' | | | Heebner Sh. | 3148' | | | Toronto Ls. | 3172' | | | Lansing -KC | 3199' | | | Base KC | 3428' | | | Arbuckle | 3482' | |
| | Name | Top | Bottom | | | | | | | | | | | | | | | | | | | | | | | | | | | | | | | |
| | Anhy. | 1098' | | | | | | | | | | | | | | | | | | | | | | | | | | | | | | | | |
| | Topeka | 2932' | | | | | | | | | | | | | | | | | | | | | | | | | | | | | | | | |
| | Heebner Sh. | 3148' | | | | | | | | | | | | | | | | | | | | | | | | | | | | | | | | |
| | Toronto Ls. | 3172' | | | | | | | | | | | | | | | | | | | | | | | | | | | | | | | | |
| | Lansing -KC | 3199' | | | | | | | | | | | | | | | | | | | | | | | | | | | | | | | | |
| | Base KC | 3428' | | | | | | | | | | | | | | | | | | | | | | | | | | | | | | | | |
| | Arbuckle | 3482' | | | | | | | | | | | | | | | | | | | | | | | | | | | | | | | | |
| <table border="1" style="width:100%; border-collapse: collapse;"> <thead> <tr> <th style="width:30%;"></th> <th style="width:15%;">Oil</th> <th style="width:15%;">Gas</th> <th style="width:15%;">Water</th> <th style="width:15%;">Gas-Oil Ratio</th> <th style="width:10%;">Gravity</th> </tr> </thead> <tbody> <tr> <td>Estimated Production Per 24 Hours</td> <td align="center">6½ Bbls</td> <td align="center">MCF</td> <td align="center">58½ Bbls</td> <td align="center">CFPB</td> <td></td> </tr> </tbody> </table> | | | | Oil | Gas | Water | Gas-Oil Ratio | Gravity | Estimated Production Per 24 Hours | 6½ Bbls | MCF | 58½ Bbls | CFPB | | | | | | | | | | | | | | | | | | | | | |
| | Oil | Gas | Water | Gas-Oil Ratio | Gravity | | | | | | | | | | | | | | | | | | | | | | | | | | | | | |
| Estimated Production Per 24 Hours | 6½ Bbls | MCF | 58½ Bbls | CFPB | | | | | | | | | | | | | | | | | | | | | | | | | | | | | | |

METHOD OF COMPLETION

Production Interval

Disposition of gas: Vented Sold Open Hole Perforation Other (Specify)

| CASING RECORD <input type="checkbox"/> New <input type="checkbox"/> Used Report all strings set-conductor, surface, intermediate, production, etc. | | | | | | | |
|--|---|--|----------------|--|----------------|-------------|----------------------------|
| Purpose of String | Size Hole Drilled | Size Casing Set (in O.D.) | Weight Lbs/Ft. | Setting Depth | Type of Cement | #Sacks Used | Type and Percent Additives |
| Surface | 12 1/4" | 8 5/8" | | 206' | 60/40 poz | 135 | |
| Production | 7 7/8" | 5 1/2" | | 3553' | ASC | 175 | |
| PERFORATION RECORD | | | | Acid, Fracture, Shot, Cement Squeeze Record (Amount and Kind of Material Used) | | | |
| Shots Per Foot | Specify Footage of Each Interval Perforated | | | | | Depth | |
| 4 | 3492-95 | | | 250 gals. mud acid | | | |
| 2 | 3375-77) | | | 500 gals. mud acid & 2000 | | | |
| 2 | 3355-59) | | | gals. 20% demul. | | | |
| 2 | 3227-30) | | | 500 gals. mud acid & 2000 | | | |
| 2 | 3204-08) | | | gals. 20% demul. | | | |
| TUBING RECORD | | | | Liner Run <input type="checkbox"/> Yes <input checked="" type="checkbox"/> No | | | |
| Size | | Set At | Packer at | | | | |
| 2 3/8" | | 3515' | none | | | | |
| Date of First Production | | Producing Method | | | | | |
| 0 12 07 | | <input type="checkbox"/> Flowing <input type="checkbox"/> Pumping <input type="checkbox"/> Gas Lift <input type="checkbox"/> Other (explain) | | | | | |