


Ellis KANSAS

SECTION 3 TOWNSHIP 13 RANGE 17W

WELL NO. #1 Schmidt "B"

COMPANY E.F. Wakefield

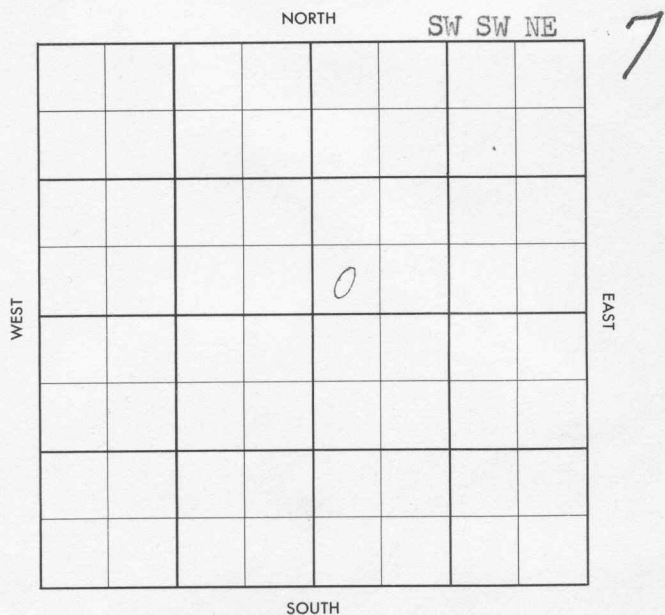

FORM 513 SUNRAY

County Ellis Elev. \_\_\_\_\_  
 Sec. 3 Twp. 13 Rge. 17W  
 Company E. F. Wakefield  
 FarmName Schmidt "B" No. 1

TOPS	DEPTH	LOG	DATUM	Loc. in Sec.
Anh.				SW SW NE
Tr.				
H.				
Tr.				
Dg.				
Bl.				
L.				Geol. _____
K.C.				Contr. _____
B.K.C.				Co. tools _____
Ce.				
C.				
M.				Pool _____
M.				Catherine
K.				
Mz.				
Ma.				
V.				
S.				
S.				
A.				
R.				
Pe.				
G.				
T.D.				

FIRST REPORT  
 MAY 22 '57

Date Comm. M I H

*[Handwritten signature]*

Co.  
 Sec.  
 No.  
 Sec.  
 T.  
 R.

FORM 513 SUNRAY

County Ellis Elev. 2031  
 Sec. 3 Twp. 13 Rge. 17W  
 Company E. F. Warefield  
 Farm Name Schmidt "B" No. 1

TOPS	DEPTH	LOG	DATUM	Loc. in Sec.
Anh.				SW SW NE
Tp.				
H.	3234			
Tr.	3257			
Dg.				
Bl.				
L.	3280			
K.C.				Geol. <u>Dent.</u>
B.K.C.				Contr.
Ce.				Co. tools
C.				
M.				Pool
M.				Catherine
K.				
Mz.				
Ma.				
V.				
S.				
S.				
A.	3539			
R.				
PE.				
G.				
TD	3557			

COMPLETE

JUL 17 57

Date Comm.

M I R

MAY 29 57 5-20-57 85/8173

1125 DST 3326-50 1hr

720' GIPD see 130' HOE GCM

BHP 830/30 DST 3380-94

30" see 8' Md BHP 0/30"

D JUN 5 '57 A16 3539 DST 3550-57

TD 1hr see 60' clean oil + 210'

HOEM BHP 960/20" RTP 3557

5/2 @ 3541 w.o.c. JUN 12 57 CO 3557

FORM 513-1 SUNRAY

TD \$ 25 Bopd nolw nat  
 +stg. JUN 19 57 1/2 JAN 25 57 \$ 30  
 Bopd 24 hrs. JUN 3 57  
 JUN 10 57 w.o.p. JUN 17 57 X Ph.P.  
 164 Bopd nolwtr (nat.)  
 A16 O.H. 3541-3557 TD  
 grav 27.7°

3-13-17W

see also map