


WELL LOG BUREAU--KANSAS GEOLOGICAL SOCIETY
508 East Murdock, Wichita, Kansas

12.13.18W

Company- DON E. PRATT
Farm- Staab "A" No. 2

SEC. 12 T. 13 R. 18W
~~G N/2 NE NE~~
SE DE DE

Total Depth. 3640'
Comm. 9-19-59 Comp. 9-26-59
Shot or Treated.
Contractor. Leben Drlg.
Issued. 11-28-59

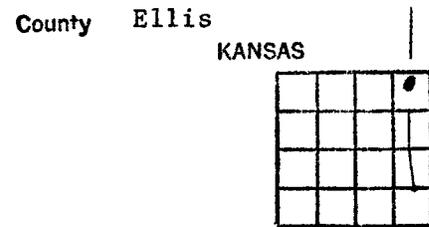

Elevation. 2080' RB

Production. Dry

CASING:

8 5/8" 155' cem w/115 sx.

Figures Indicate Bottom of Formations.

surface clay & sand	40
shale	155
shale, shells, sand & red bed	760
shale, sand & shells	1230
shale & sand	1325
Anhydrite	1345
shale & shells	1950
lime	2005
shale & lime	2210
lime	2495
lime & shale	2685
shale & lime	2980
shale	3090
shale & lime	3250
lime	3640 RTD
lime	3649
Total Depth	

TOPS:

Topeka	3081
Heebner	3318
Toronto	3338
Lansing	3363
Kansas City Base	3602
Conglomerate	3612