

14-13-21W

TYPE

AFFIDAVIT OF COMPLETION FORM
State Geological Survey

ACO-1 WELL HISTORY

SIDE ONE

WICHITA BRANCH

Two (2) copies of this form shall be filed with the Kansas Corporation Commission, 200 Colorado Derby Building, Wichita, Kansas 67202, within thirty (30) days after the completion of a well, regardless of how the well was completed.

Attach separate letter of request if the information is to be held confidential. If confidential, only file one copy. Information on Side One will be of public record and Side Two will then be held confidential.

Applications must be made on dual completion, commingling, salt water disposal, injection and temporarily abandoned wells.

Attach one copy only wireline logs (i.e. electrical log, sonic log, gamma ray neutron log, etc.). (Rules 82-2-105 & 82-2-125) KCC# (316) 263-3238.

LICENSE # 5088 EXPIRATION DATE July 1983

OPERATOR John Jay Darrah, Jr. API NO. 15-195-21,193

ADDRESS 405 Century Plaza COUNTY Trego

Wichita, Kansas 67202 FIELD

** CONTACT PERSON Dianne R. Fowler PROD. FORMATION Arbuckle
PHONE (316) 263-2243

PURCHASER Derby LEASE Schmeidler

ADDRESS 200 Colorado Derby Bldg. WELL NO. 2

Wichita, Kansas 67202 WELL LOCATION C SW SW NE

DRILLING CONTRACTOR Mallard Drilling Co., Inc. (5651) 2310Ft. from N Line and

ADDRESS 405 Century Plaza 2310Ft. from E Line of

Wichita, Kansas 67202 the ~~xxx(over)~~ SEC 14 TWP 13 RGE 21 W


PLUGGING NA

CONTRACTOR

ADDRESS

WELL PLAT

(Office Use Only)

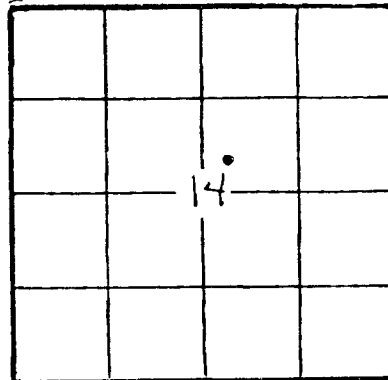

KCC

KGS

SWD/REP

PLG.

TOTAL DEPTH 3866 PBT

SPUD DATE 3/30/83 DATE COMPLETED

ELEV: GR 2171 DF 2175 KB 2179

DRILLED WITH ~~CABLE~~ (ROTARY) ~~XXX~~ TOOLS.

DOCKET NO. OF DISPOSAL OR REPRESSURING WELL BEING USED TO DISPOSE OF WATER FROM THIS LEASE CR-7816

Amount of surface pipe set and cemented 254' DV Tool Used? yes

THIS AFFIDAVIT APPLIES TO: (Circle ONE) - Oil, Gas, Shut-in Gas, Dry, Disposal, Injection, Temporarily Abandoned, OWWO. Other

ALL REQUIREMENTS OF THE STATUTES, RULES AND REGULATIONS PROMULGATED TO REGULATE THE OIL AND GAS INDUSTRY HAVE BEEN FULLY COMPLIED WITH.

A F F I D A V I T

JOHN JAY DARRAH, JR., being of lawful age, hereby certifies that:

I am the Affiant, and I am familiar with the contents of the foregoing Affidavit. The statements and allegations contained therein are true and correct.

John Jay Darrah

OPERATOR John Jay Darrah, Jr LEASE Schmeidler SEC.14 TWP.13 RGE.21W

FILL IN WELL LOG AS REQUIRED:

Show all important zones of porosity and contents thereof; cored intervals, and all drill-stem tests, including depth interval tested, cushion used, time tool open, flowing and shut-in pressures, and recoveries.

SHOW GEOLOGICAL MARKERS LOGS RUN, OR OTHER DESCRIPTIVE INFORMATION.

FORMATION DESCRIPTION, CONTENTS, ETC.	TOP	BOTTOM	NAME	DEPTH
Surface soil, sand	0	1545	(no logs run)	
Anhydrite	1545	1588		
Shale	1588	3248		
Lime & shale	3248	3866		

Amount and kind of material used	Depth interval treated
(none)	

Date of first production 6/11/83	Producing method (flowing, pumping, gas lift, etc.) pumping	Gravity
-------------------------------------	--	---------

RATE OF PRODUCTION PER 24 HOURS	Oil 94	Gas none	Water 9 %	Gas-oil ratio 11	CFPB
---------------------------------	-----------	-------------	--------------	---------------------	------

Disposition of gas (vented, used on lease or sold) none	Perforations
--	--------------

DST#1 3800-3866 30-45-45-45 Recovered 1700' O & MCO, 24 bbls. total IFP 149-522 SIP 867-805 HYD 1978-1936				
---	--	--	--	--

Report of all strings set — surface, intermediate, production, etc. **CASING RECORD** (New) or (Used)

Purpose of string	Size hole drilled	Size casing set (in O.D.)	Weight lbs/ft.	Setting depth	Type cement	Sacks	Type and percent additives
Surface	12 1/4	8 5/8	23#	263'	common	165	3% CaCl, 2% gel
Production	7 7/8	4 1/2	9 1/2#	3849'	60/40 poz.	150	10% salt, 5sx sal flush
					50/50 poz.	350	6% gel

LINER RECORD

PERFORATION RECORD

Top, ft.	Bottom, ft.	Sacks cement	Shots per ft.	Size & type	Depth interval
TUBING RECORD					
Size 2"	Setting depth 3775	Packer set at			

ACID, FRACTURE, SHOT, CEMENT SQUEEZE RECORD