

Ind.

STATE CORPORATION COMMISSION OF KANSAS
OIL & GAS CONSERVATION DIVISION

WELL COMPLETION OR RECOMPLETION FORM
ACO-1 WELL HISTORY

DESCRIPTION OF WELL AND LEASE

Operator: License #6249.....
Name Zenith Petroleum Corporation.....
Address 1235 N. Loop West Suite 919.....
City/State/Zip Houston, Texas 77008.....

Purchaser Koch Oil Company.....
P.O. Box 2256, Wichita, KS 67201.....

Operator Contact Person Joe Gibson.....
Phone 713-863-7741.....

Contractor: License #5671.....
Name Reylin Drlg, Inc.....

Wellsite Geologist.....
Phone.....

Designate Type of Completion

- New Well Re-Entry Workover
- Oil SWD Temp Abd
- Gas Inj Delayed Comp.
- Dry Other (Core, Water Supply etc.)

If ONNO: old well info as follows:

Operator
Well Name
Comp. Date Old Total Depth.....

WELL HISTORY

Drilling Method:

- Mud Rotary Air Rotary Cable

8-10-85... 8-16-85... 9-10-85...
Spud Date Date Reached TD Completion Date

4030... 3925'
Total Depth PBTD

Amount of Surface Pipe Set and Cemented at 259 feet
Multiple Stage Cementing Collar Used? Yes No
If yes, show depth set.....feet
If alternate 2 completion, cement circulated
rom.....feet depth to.....w/.....SX cmt

API NO. 15-195-21,756

County Trego

NE.. NE.. NW.. Sec..17. Twp..13. Rge..21.. East West

4950 Ft North from Southeast Corner of Section
2970 Ft West from Southeast Corner of Section

(Note: Locate well in section plat below)


Lease Name Keller Well # A-11

Field Name Riga, Northwest

Producing Formation Marmaton

Elevation: Ground 2187 KB 2192

Section Plat

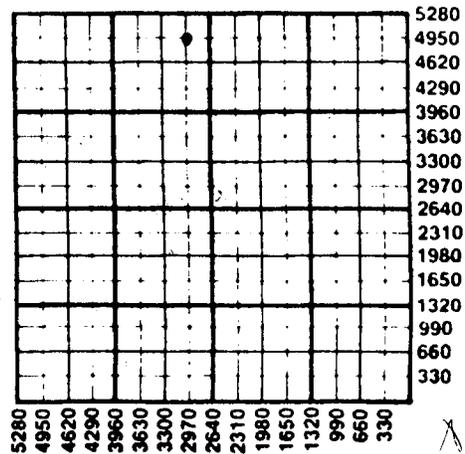

WATER SUPPLY INFORMATION

Disposition of Produced Water: Disposal Repressuring
Docket #

Questions on this portion of the ACO-1 call:

Water Resources Board (913) 296-3717

Source of Water:

Division of Water Resources Permit #.....

Groundwater.....Ft North from Southeast Corner
(Well)Ft West from Southeast Corner of
Sec Twp Rge East West

Surface Water.....Ft North from Southeast Corner
(Stream, pond etc).....Ft West from Southeast Corner
Sec Twp Rge East West

Other (explain) pump from stream less than 15' acr
(purchased from city, R.W.D. #)

INSTRUCTIONS: This form shall be completed in duplicate and filed with the Kansas Corporation Commission, 200 Colorado Derby Building, Wichita, Kansas 67202, within 90 days after completion or recompletion of any well. Rule 82-3-130 and 82-3-107 apply.

Information on side two of this form will be held confidential for a period of 12 months if requested in writing and submitted with the form. See rule 82-3-107 for confidentiality in excess of 12 months.

One copy of all wireline logs and drillers time log shall be attached with this form. Submit CP-4 form with all plugged wells. Submit CP-111 form with all temporarily abandoned wells.