


KANSAS CORPORATION COMMISSION

WELL RECORD

ail to Kansas Geological Survey, 4150 Monroe Street, Wichita, Kansas 67209)

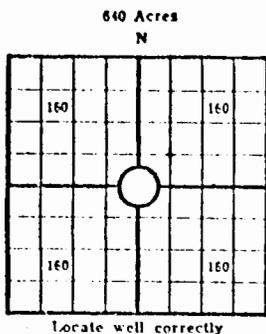

Lease Name: Herbert "A" Well No. 1  
 Well Located: S/2 SW NW  
Trego SEC 19 TWP 13S RGE 21W  
 Operator: Pickrell Drilling Company  
 Address: 705 Fourth Nat'l Bank Building  
 Elevation: Ground 2266 D.F. 2269 K.B. 2271  
 Type Well: (Oil, gas, dry hole) Dry Hole

Drilling Commenced: May 1, 1974 Drilling Completed: May 10, 1974  
 Well Completed: May 10, 1974 Total Depth 4070  
 Initial Production: None

Casing Record

Size: 8 5/8 Set at 209.93' Size: \_\_\_\_\_ Set at \_\_\_\_\_  
 Size: \_\_\_\_\_ Set at \_\_\_\_\_ Size: \_\_\_\_\_ Set at \_\_\_\_\_

Liner Record

Size: \_\_\_\_\_ Set from \_\_\_\_\_ To \_\_\_\_\_

Cementing

<u>Casing Size</u>	<u>Sacks</u>	<u>Type Cement and Additives</u>
<u>8 5/8</u>	<u>150</u>	_____
_____	_____	_____
_____	_____	_____

Perforations

<u>Formation</u>	<u>Perforated Interval and Number Shots</u>
_____	_____
_____	_____
_____	_____

Electric Log Run (Show type log and depths covered)

No Electric Logs

(Fill in formation and related information on reverse side)

19-13-21w

FORMATION, TESTING AND COMPLETION RECORD

Show Drill Stem Tests,  
Well Stimulation and  
Production Tests

Formation      Top      Bottom

Formation	Top	Bottom
Post Rock	0	70
Shale & Shells	70	218
Shale & Sand	218	1550
Sand Streaks & Shale	1550	2036
Lime & Shale	2036	3810
Lime	3810	3825
Lime & Shale	3825	3965
Lime	3965	4070

DST #1. 3614-3636, Open 1 hour, weak 17" blow, recovered 30' mud, IFP 33-44#, FFP 44-44#, ISIP 469#/30, FSIP 415#/30"

DST #2 3640-3662, Open 1 hour weak 16" blow, recovered 15' mud, IFP 33-33#, FFP 44-44#, ISIP 459#/30", FSIP 448#/30", Drilling Ahead.

DST #3. Open 1 hour, weak 5" blow, recovered 5' mud, IFP 33-44#, FFP 44-44#, ISIP 55#/30", FSIP 55#/30". Kansas City 3755' (-1484). Drilling Ahead.

DST #4 3735-3810', Open 60', weak 14" blow, recovered 20' sl. OCM, IFP 55-55#, FFP 55-55#, ISIP 621#/30", FSIP 556#/30", Stark Sh. 3819' (-1548') Base Kansas City 3868' (-1597)

DST # 5 4049-4070, Open 2 hours, Strong blow Recovered 1130' muddy salt water. IFP 66-240 FFP 262-534, ISIP 1009/30 FSIP 912/60, RTD 4070 (-1799)

19-13-21w