

State Geological Survey

WICHITA BRANCH
KANSAS DRILLERS LOG

IMPORTANT
Kans. Geo. Survey request
samples on this well.

15-199-20021

API No. 15 — 199 — 20,021
County Number

Operator

Burnett Corp.

Address

Suite 450 First National Bank Bldg. Amarillo, Texas

Well No.

#1

Lease Name

Finley

Footage Location

660 feet from (X) (S) line 1980 feet from (E) (V) line

Principal Contractor

D.N.B. DRILLING, INC.

Geologist

C. C. Vaughan

Spud Date

September 21, 1977

Total Depth

5160'

P.B.T.D.

Date Completed

September 30, 1977

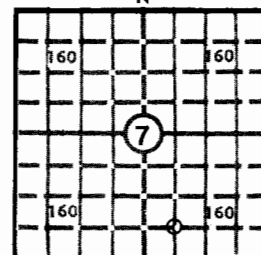
Oil Purchaser

N.A.

S. 7 T. 13 R. 39 E W

Loc. C SW SE

County Wallace

640 Acres
N

Locate well correctly

Elev.: Gr. 3454'

DF 3457' KB 3459'

CASING RECORD

Report of all strings set — surface, intermediate, production, etc.

Purpose of string	Size hole drilled	Size casing set (in O.D.)	Weight lbs/ft.	Setting depth	Type cement	Sacks	Type and percent additives
Surface Casing	12 1/4" 7 7/8"	8 5/8"	20#	331'	Class "H"	275	2% cc w/1/4#/sk Flo-cele

LINER RECORD

PERFORATION RECORD

Top, ft.	Bottom, ft.	Sacks cement	Shots per ft.	Size & type	Depth interval

Size	Setting depth	Packer set at			

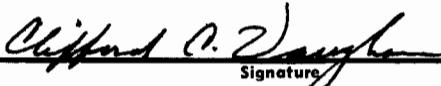
ACID, FRACTURE, SHOT, CEMENT SQUEEZE RECORD

Amount and kind of material used	Depth interval treated

INITIAL PRODUCTION

Date of first production	Producing method (flowing, pumping, gas lift, etc.)				
D & A					
RATE OF PRODUCTION PER 24 HOURS	Oil	Gas	Water	Gas-oil ratio	CFPB
	bbls.	MCF	bbls.		
Disposition of gas (vented, used on lease or sold)			Producing interval(s)		

INSTRUCTIONS: As provided in KCC Rule 82-2-125, within 90 days after completion of a well, one completed copy of this Drillers Log shall be transmitted to the State Geological Survey of Kansas, 4150 Monroe Street, Wichita, Kansas 67209. Copies of this form are available from the Conservation Division, State Corporation Commission, 3830 So. Meridian (P.O. Box 17027), Wichita, Kansas 66217. Phone AC 316-522-2206. If confidential custody is desired, please note Rule 82-2-125. Drillers Logs will be on open file in the Oil and Gas Division, State Geological Survey of Kansas, Lawrence, Kansas 66044.

Operator Burnett Corporation		DESIGNATE TYPE OF COMP.: OIL, GAS, DRY HOLE, SWDW, ETC.:	
Well No. 1	Lease Name Finley		Dry Hole	
S <u>7</u> T <u>13</u> R <u>39</u> ^{BK} _W	
WELL LOG		SHOW GEOLOGICAL MARKERS, LOGS RUN, OR OTHER DESCRIPTIVE INFORMATION.	
Show all important zones of porosity and contents thereof; cored intervals, and all drill-stem tests, including depth interval tested, cushion used, time tool open, flowing and shut-in pressures, and recoveries.	
FORMATION DESCRIPTION, CONTENTS, ETC.	TOP	BOTTOM	NAME DEPTH	
<u>ELECTRIC LOG TOPS</u> <table style="width: 100%; border-collapse: collapse;"> <tr> <td style="width: 50%;">Stone Corral Anhydrite</td> <td style="width: 10%; text-align: center;">2655</td> <td style="width: 10%; text-align: center;">2686</td> <td style="width: 30%;"></td> </tr> <tr> <td>Neva Lime</td> <td style="text-align: center;">3253</td> <td></td> <td></td> </tr> <tr> <td>Heebner Shale</td> <td style="text-align: center;">3960</td> <td></td> <td></td> </tr> <tr> <td>Toronto Lime</td> <td style="text-align: center;">3988</td> <td></td> <td></td> </tr> <tr> <td>Lansing-Kansas City</td> <td style="text-align: center;">4014</td> <td style="text-align: center;">4393</td> <td></td> </tr> <tr> <td>Marmaton</td> <td style="text-align: center;">4402</td> <td></td> <td></td> </tr> <tr> <td>Cherokee Shale</td> <td style="text-align: center;">4544</td> <td></td> <td></td> </tr> <tr> <td>Morrow Shale</td> <td style="text-align: center;">4774</td> <td></td> <td></td> </tr> <tr> <td>St. Louis</td> <td style="text-align: center;">4884</td> <td></td> <td></td> </tr> <tr> <td>Spergen</td> <td style="text-align: center;">4058</td> <td></td> <td></td> </tr> <tr> <td>Osage</td> <td style="text-align: center;">5144</td> <td></td> <td></td> </tr> </table> No Shows No Cores No DSTs				Stone Corral Anhydrite	2655	2686		Neva Lime	3253			Heebner Shale	3960			Toronto Lime	3988			Lansing-Kansas City	4014	4393		Marmaton	4402			Cherokee Shale	4544			Morrow Shale	4774			St. Louis	4884			Spergen	4058			Osage	5144		
Stone Corral Anhydrite	2655	2686	
Neva Lime	3253	
Heebner Shale	3960	
Toronto Lime	3988	
Lansing-Kansas City	4014	4393	
Marmaton	4402	
Cherokee Shale	4544	
Morrow Shale	4774	
St. Louis	4884	
Spergen	4058	
Osage	5144	
USE ADDITIONAL SHEETS, IF NECESSARY, TO COMPLETE WELL RECORD.	
Date Received	 Signature Vice President Title October 12, 1977 Date	

DRILLERS' LOG

BURNETT CORPORATION
No. 1 Finley
C SW SE Sec. 7-13S-39W
Wallace Co., Kansas

Commenced: 9-21-77
Completed: 9-30-77

Surface Casing: 323' of 8-5/8"
cmt'd w/265 sx Class H, 3% cc
9-21-77

FORMATION

DEPTH

Surface Hole	0 - 331
Shale & Sand	331 - 1220
Shale	1220 - 2209
Lime & Shale	2209 - 2440
Lime, Shale & Sand	2440 - 2775
Lime & Shale	2775 - 3050
Lime, Shale & Sand	3050 - 3265
Lime & Shale	3265 - 3990
Lime, Shale & Chert	3990 - 4125
Lime & Shale	4125 - 4388
Lime	4388 - 4613
Lime & Shale	4613 - 4706
Lime	4706 - 4925
Miss. Lime & Chert	4925 - 5004
Lime	5004 - 5260 RTD

I do hereby certify that the foregoing statements are true and correct to the best of my knowledge and belief.

D N B DRILLING, INC.

Ella Priess

Ella Priess

STATE OF KANSAS: ss:

Subscribed and sworn to before me this 3rd day of October, 1977.

DOROTHY L. SCHMIDT
STATE NOTARY PUBLIC
Sedgwick County, Kansas
My Appt. Exp. April 30, 1979

Dorothy L. Schmidt
Dorothy L. Schmidt, Notary Public