


Pool Name Wildcat
 Map No. 51 KANSAS Sec. 17 Twp. 14 R. 1W
 Well No. 1 Ryan
Phillips Company
FIRST REPORT Contractor
NE SE

SECTION PLAT

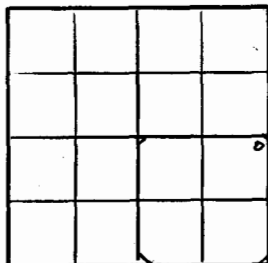

330 Ft. from N. Line
 _____ Ft. from S. Line
330 Ft. from E. Line
 _____ Ft. from W. Line

Saline


Location <u>X</u>	RECORD
Rig up _____	Cased _____ in. _____ ft.
Drilling and Remarks:	Sand _____
	Gas _____
	Oil _____
	Total Depth _____
	PRODUCTION
	1st 24 hrs. Nat. _____
	1st 24 hrs. after shot _____
	Gas _____ Cu. Ft.
	Dry Hole _____
	Abandoned _____

Date

SEP 13 1944 19 S. J. LEWIS Scout

Pool Name Wildcat
 Map No. 51 KANSAS Sec. 17 Twp. 14 R. 1W
 Well No. 1 Ryan
Phillips Company
ABANDONED Contractor
NE SE

SECTION PLAT

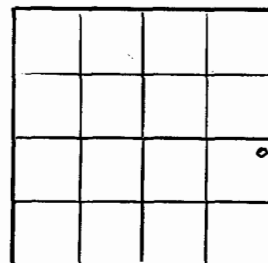

330 Ft. from N. Line
 _____ Ft. from S. Line
330 Ft. from E. Line
 _____ Ft. from W. Line

Saline

Location _____	RECORD
Rig up _____	Cased _____ in. _____ ft.
Drilling and Remarks:	Sand _____
<u>Art 3412</u>	Gas _____
	Oil _____
	Total Depth <u>3568</u>
	PRODUCTION
	1st 24 hrs. Nat. _____
	1st 24 hrs. after shot _____
	Gas _____ Cu. Ft.
	Dry Hole _____
	Abandoned _____

Date

OCT 18 1944 19 S. J. LEWIS Scout

Sec. 17 Twp. 14 R. 1W

Well No. 1 Ryan Farm

Phillips Company


NE SE

330 Ft. from N. Line

Ft. from S. Line

330 Ft. from E. Line

Ft. from W. Line

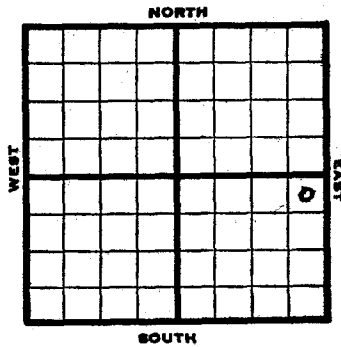

1944

REPORT

9-13 Location
9/21 Dellar
9/28 Drlg. 1590
10/4 Drlg. 2738
10/11 Lans 1934
Miss 2580
Kind 2814
Hunton 2965
Viola 3226
Si p Sd 3369
Arb 3412
drlg. 3467
No shows
10/18 Arb 3412
TD 3568

ABANDONED

Section 17 Township 14 Range 1W

Well No. #1 Ryan

Company Phillips Pet.

