

KANSAS
Map No. 5 / Sec. 35 Twp. 14 R. 1WWell No. 1 Lattin

Harbar & Sinclair & Prairie Company

FIRST REPORT

Contractor

C S L NW NE


SECTION PLAT

990 Ft. from N. Line

Ft. from S. Line

Ft. from E. Line

660 Ft. from W. Line

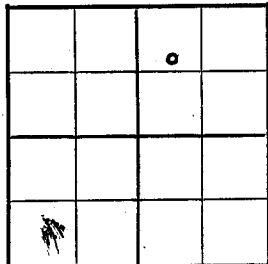

Wildcat

Location

Rig up

Drilling and Remarks:

Derrick

RECORD

Cased 1 in. ft.

Sand

Gas

Oil

Total Depth

PRODUCTION

1st 24 hrs. Nat.

1st 24 hrs. after shot

Gas Cu. Ft.

Dry Hole

Abandoned

Date

JAN 12 1944 19

S. J. LEWIS

Scout

KANSAS
Map No. 5 / Sec. 35 Twp. 14 R. 1WWell No. 1 Lattin

Harbar & Sinclair Prairie Company

ABANDONED

Contractor

C S L NW NE


SECTION PLAT

990 Ft. from N. Line

Ft. from S. Line

Ft. from E. Line

660 Ft. from W. Line

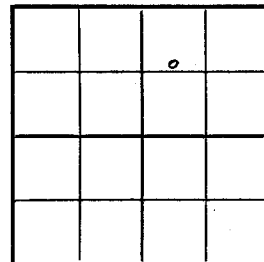

Wildcat

Location

Rig up

Drilling and Remarks:

Name 1930

Nier 2577

72727

RECORD

Cased in. ft.

Sand

Gas

Oil

Total Depth 2727

PRODUCTION

1st 24 hrs. Nat.

1st 24 hrs. after shot

Gas Cu. Ft.

Dry Hole

Abandoned

Date

FEB 9 1944 19


S. J. LEWIS Scout

Sec. 35 Twp. 14 R. 1-W

Well No. #1 Lattin Farm

Harbar & Sinclair & Prairie Company

NORTH

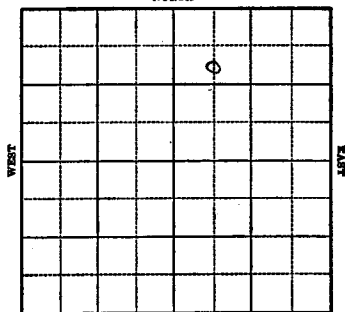

990 Ft. from N. Line

_____ Ft. from S. Line

_____ Ft. from E. Line

660 Ft. from W. Line

Elev. 1264

R E P O R T

1944

1-12 Derrick

1/19 10" @ 81
Drlg. 470'

1/26 D lg. 2185'

2/2 Miss 2577
Drlg. 2715'

2/9 Lans 1930
Miss 2577
TD 2727'


ABANDONED

Section 35 Township 14 Range 1-W

Well No. #1 Lattin

Company Harbar & Sinclair & Prairie

NORTH

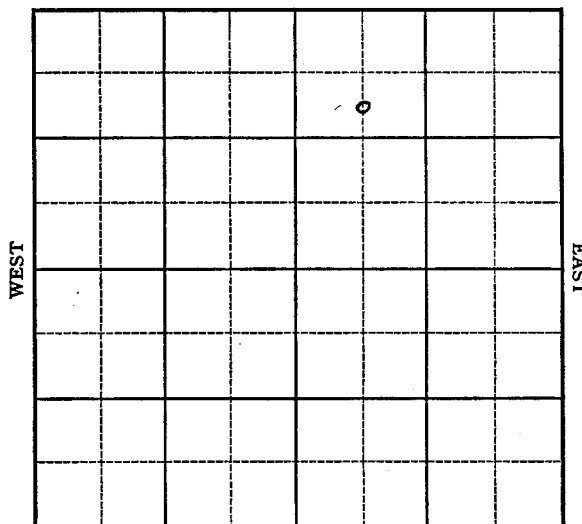

SOUTH