


Section 1 Township 14 Range 16W

Well No. 2 Behrens

Company Cinoil

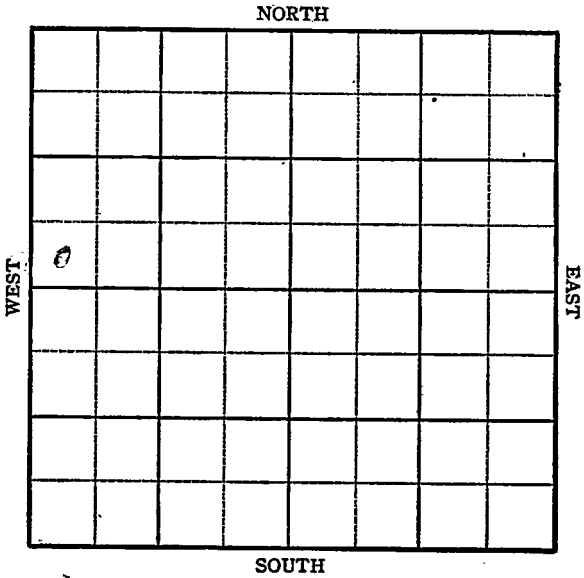

Sec. 1 Twp. 14 R. 16W

Well No. #2 Behrens Farm

Cinoil Company

Wildcat


_____ Ft. from N. Line

330 _____ Ft. from S. Line

_____ Ft. from E. Line

330 _____ Ft. from W. Line

SW NW

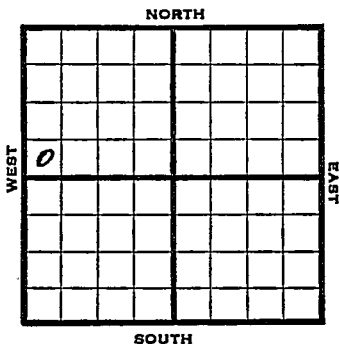

1945

Elev. 1928 REPORT

- 10/31 Drlg. 1040'
- 11/7 10" @ 1763 WOC
- 11/14 Drlg. 3060'
- 11/21 Lans 3138
- Arb. 3480
- TD 3492'

ABANDONED

KANSAS

Kansas Pool Name Wildcat

Map No. 77 Sec. 1 Twp. 14 R. 16W

Well No. 2 Behrens

Cinoil Company

FIRST REPORT

Contractor

SW NW

SECTION PLAT

 Ft. from N. Line

330 Ft. from S. Line

 Ft. from E. Line

330 Ft. from W. Line

| | | | |
|--|--|--|--|
| | | | |
| | | | |
| | | | |
| | | | |

Ellis County

Location

Rig up

Drilling and Remarks:

1040

RECORD

Cased in., ft.

Sand

Gas

Oil

Total Depth

PRODUCTION

1st 24 hrs. Nat.

1st 24 hrs. after shot

Gas Cu. Ft.

Dry Hole

Abandoned

Date

OCT 3 1 1945 19

S. J. LEWIS Scout

KANSAS

Kansas

Pool Name Wildcat

Map No. 71 Sec. 1 Twp. 14 R. 16W

Well No. 2 Behrens

Cinoil

Company

ABANDONED

Contractor

SW NW

E 11, 1928
SECTION PLAT

_____ Ft. from N. Line

330 Ft. from S. Line

_____ Ft. from E. Line

330 Ft. from W. Line

| | | | |
|--|--|--|--|
| | | | |
| | | | |
| | | | |
| | | | |

Ellis County

Location _____

Rig up _____

Drilling and Remarks:

4002 3135

Cor 48480

RECORD

Cased _____ in., _____ ft.

Sand _____

Gas _____

Oil _____

Total Depth 2492

PRODUCTION

1st 24 hrs. Nat. _____

1st 24 hrs. after shot _____

Gas _____ Cu. Ft.

Dry Hole _____

Abandoned _____

Date

NOV 2 1 1945

19

S. J. LEWIS Scout