

KANSAS

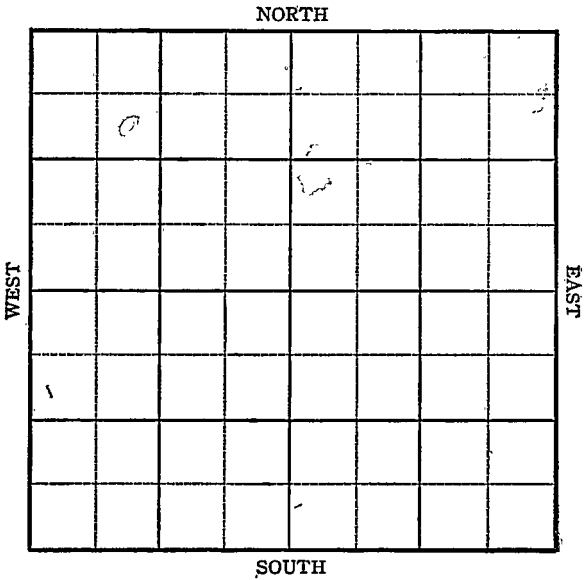
Ellis
F

FORM 51 5M PETROL

Section 1 Township 14 Range 16W

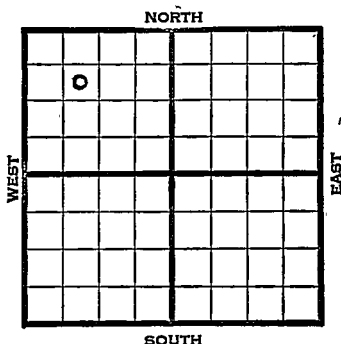
Well No. 1 Berens "A"

Company Cinoil



KANSAS

Ellis

Sec. 1 Twp. 14 R. 16-WWell No. #1 Berens "A" FarmCinoil Company990 Ft. from N. Line Ft. from S. Line Ft. from E. Line990 Ft. from W. Line

SE NW NW

1945

E. 1915

REPORT

8/1

150'

8/8

Anhy 1010

8" @ 1018

Drlg. 2806

8/15

Topeka 2892

Coring 2966

8/22

Drlg. 3125

8/29

Lans 3153

Drlg. 3220

9/5

Drlg. 3350

9/12

Drlg. 3440'

9/19

Cong 3415'

Arb. 3450 $\frac{1}{2}$

TD 3469'

5" @ 3469' RUST

9/26

" " "

10/3

PB 3441

12 shots 3339-3343 9500 acid.

3 oil per hr. No Wtr.

Plug 3333

24 shots 3313-3321

2000' acid. 2 oil per hr.

10/10

Arb. 3450 $\frac{1}{2}$

TD 3469'

ABANDONED

KANSASPool Name WildcatMap No. 71 Sec. 1 Twp. 14 R. 16WWell No. 1 Berens "A"

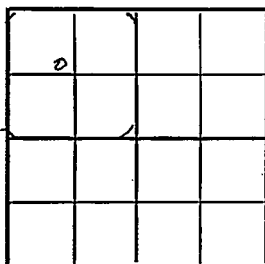
Cinoil

Company

FIRST REPORT

Contractor

SE NW NW

SECTION PLAT990 Ft. from N. Line Ft. from S. Line Ft. from E. Line990 Ft. from W. LineEllis CountyLocation Rig up

Drilling and Remarks:

150'**RECORD**Cased in., ft.Sand Gas Oil Total Depth **PRODUCTION**1st 24 hrs. Nat. 1st 24 hrs. after shot Gas Cu. Ft.Dry Hole Abandoned

Date

AUG 1 1945 19S. J. LEWIS

Scout

KANSASKansas Pool Name WildcatMap No. 71 Sec. 1 Twp. 14 R. 16WWell No. 1 Berens "A"

Cinoil _____ Company

ABANDONED

Contractor

SE NW NW

E. 1915
SECTION PLAT990 Ft. from N. Line

_____ Ft. from S. Line

_____ Ft. from E. Line

990 Ft. from W. Line

0			

Ellis county

Location _____

Rig up _____

Drilling and Remarks:

*Cor 83450 1/2***RECORD**

Cased _____ in., _____ ft.

Sand _____

Gas _____

Oil _____

Total Depth 8469**PRODUCTION**

1st 24 hrs. Nat. _____

1st 24 hrs. after shot _____

Gas _____ Cu. Ft.

Dry Hole _____

Abandoned _____

Date

OCT 10 1945 19 S. J. LEWIS Scout