


Section 1 Township 14 Range 15-W

Well Number 4-Ehrlich

Company Gulf

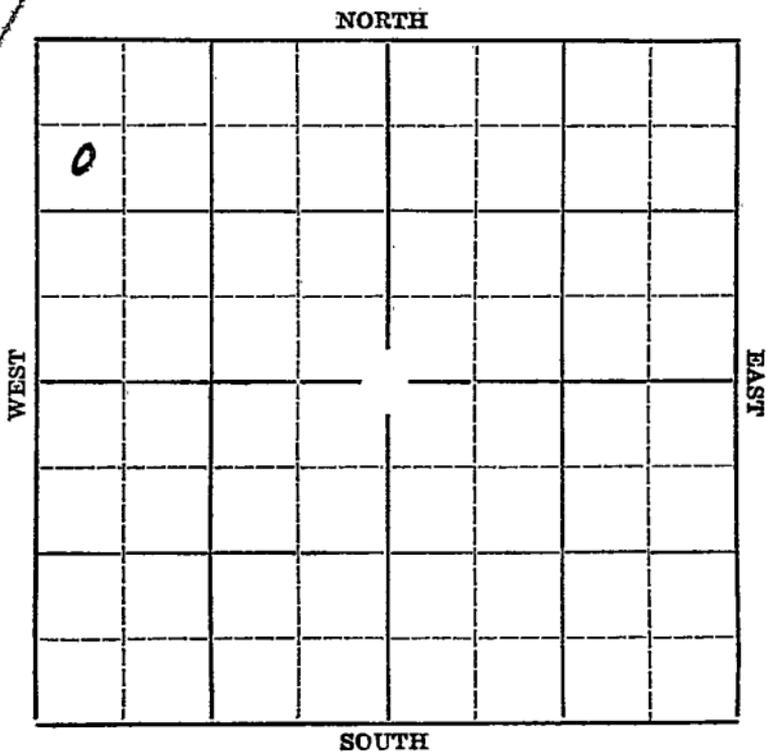

**KANSAS**

Map No. \_\_\_\_\_ Sec. 1 Twp. 14 R. 15-W


Well No. 4-Ehrlich Farm \_\_\_\_\_  
Gulf Company \_\_\_\_\_

990 Ft. from N. Line

\_\_\_\_\_ Ft. from S. Line

\_\_\_\_\_ Ft. from E. Line

330 Ft. from W. Line

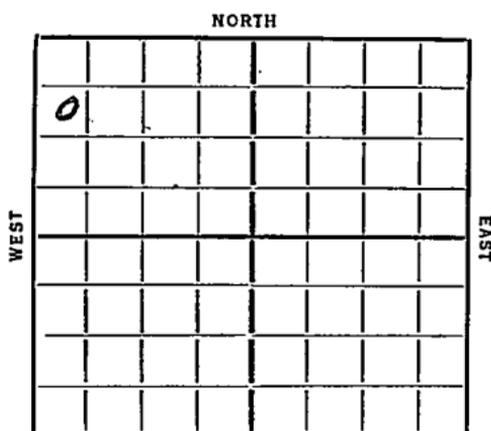

Elev. 1893

Date	REPORT
1936	
4/15	Cable tool rig
4/23	Rigging up.
4/30	12" @ 605'. Drlg. 655'
5/7	Drlg. 1985'.
5/14	S.O. 2485-90'. 8" @ 2562 drlg.
5/20	Lansing 3047'. Set. 6" @ 3058'.
5/28	3303'. U.R. 6".
6/4	Gorham 3304'. T.D. 3306½'.
6/11	T.D. 3316'. Swab 265 bbls oil in 10 hours.
6/24	4/36-Gorham 3304'.
	T.D. 3316'.
	Pump 341 bbls oil and 17 bbls of water.
	<b>COMPLETED</b>

Map No. 72 Sec. 1 Twp. 14 R. SW

Well No. 4 Ekstich

Gulf Company

Contractor

**SECTION PLAT**

990 Ft. from N. Line

..... Ft. from S. Line

..... Ft. from E. Line

320 Ft. from W. Line

0.			

**FIRST REPORT**

Location.....

Rig up.....

Drilling and Remarks:

*Cable Tool  
Rig*

**RECORD**

Cased..... in., ..... ft.

Sand.....

Gas.....

Oil.....

Total Depth.....

**PRODUCTION**

1st 24 hrs. Nat.....

1st 24 hrs. after shot.....

Gas..... Cu. Ft.

Dry Hole.....

Abandoned.....

Date

APR 15 1936

S. J. LEWIS

192.....

Scout

*Russell*

Map No. 72 Sec. 1 Twp. 14 R. 15W

Well No. 4 Ehrlich

Gulley Company

Contractor

SECTION PLAT

0.			

990 Ft. from N. Line

\_\_\_\_\_ Ft. from S. Line

\_\_\_\_\_ Ft. from E. Line

330 Ft. from W. Line

COMPLETED

Location \_\_\_\_\_

Rig up \_\_\_\_\_

Drilling and Remarks:

*See log 3304*

*Pump. 341 oil  
17 Water*

RECORD

Cased \_\_\_\_\_ in., \_\_\_\_\_ ft.

Sand \_\_\_\_\_

Gas \_\_\_\_\_

Oil \_\_\_\_\_

Total Depth 3316

PRODUCTION

1st 24 hrs: Nat. \_\_\_\_\_

1st 24 hrs. after shot \_\_\_\_\_

Gas \_\_\_\_\_ Cu. Ft.

Dry Hole \_\_\_\_\_

Abandoned \_\_\_\_\_

Date

JUN 24 1936 19

S. J. LEWIS

Scout