


Section 1 Township 14 Range 15W

Well No. #2 Ehrlich "A"

Company Lindas Oil

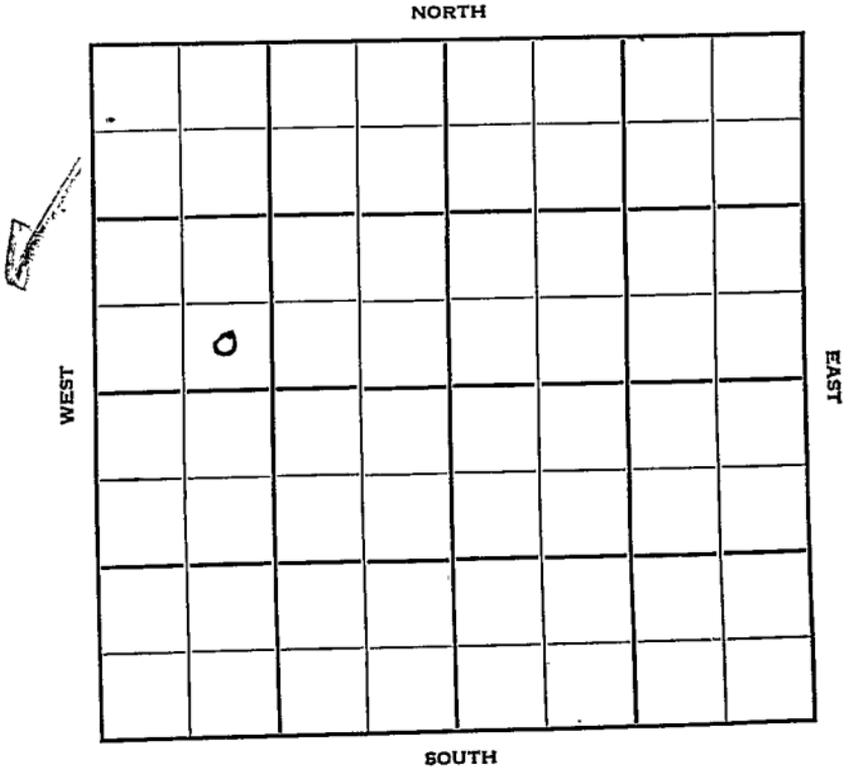

Sec. 1 Twp. 14 R. 15-W ✓

Well No. #2 Ehrlich "A" Farm

Lindas Oil Company

Contractor

Gorham Pool


Ft. from N. Line

370 Ft. from S. Line

Ft. from E. Line

930 Ft. from W. Line

SE SW NW

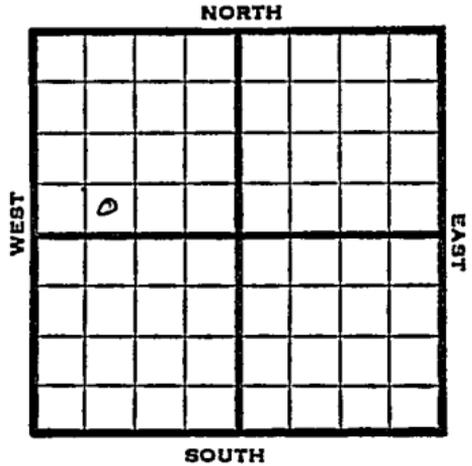

1950

Elev 1884' REPORT

2/1
3/22

MIM
12" @ 420'
10" @ 590'
Anhy 915'
8" @ 931'
Topeka 2780'
SD 2781-83
TD 2945'
D&A
Aband.

ABANDONED

Map No. _____ Sec. 1 Twp. 14 R. 15WWell No. 2 Ehrlich "A"_____ Lindas Oil _____ Company

_____ Contractor

SE SW NW


_____ Ft. from N. Line

370 Ft. from S. Line

_____ Ft. from E. Line

930 Ft. from W. Line

SECTION PLAT

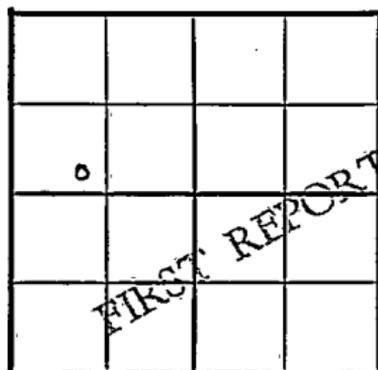

Russell County

Location _____

Rig up _____

Drilling and Remarks:

M I M

RECORD

Cased _____ in., _____ ft.

Sand _____

Gas _____

Oil _____

Total Depth _____

PRODUCTION

1st 24 hrs. Nat. _____

1st 24 hrs. after shot _____

Gas _____ Cu. Ft.

Dry Hole _____

Abandoned _____

Date

FEB 1 1950 19J. E. TYRA Scout

Map No. _____ Sec. 1 Twp. 14 R. 15WWell No. 2 Ehrlich "A"Lindas Oil Company

Contractor


SE SW NW

E1. 1884
SECTION PLAT

_____ Ft. from N. Line

370 Ft. from S. Line

_____ Ft. from E. Line

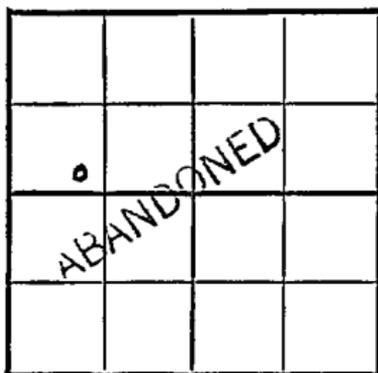930 Ft. from W. Line

Russell County

Location _____

Rig up _____

Drilling and Remarks:

12" @ 420
10" @ 590
any 915
8" @ 931
Topless 2780
SO 2781-83
T.D. 2945
D+A

RECORD

Cased _____ in., _____ ft.

Sand _____

Gas _____

Oil _____

Total Depth _____

PRODUCTION

1st 24 hrs. Nat. _____

1st 24 hrs. after shot _____

Gas _____ Cu. Ft.

Dry Hole _____

Abandoned _____

Date

MAR 22 1950 19 J. E. TYRA Scout