



Russell

Map No. KANSAS Sec. 1 Twp. 14 R. 15<sup>w</sup>

Well No. 1 - Ehrlich Farm

Peppy Oil Company


         Ft. from N. Line

330 Ft. from S. Line

         Ft. from E. Line

330 Ft. from W. Line

Elev. 1889

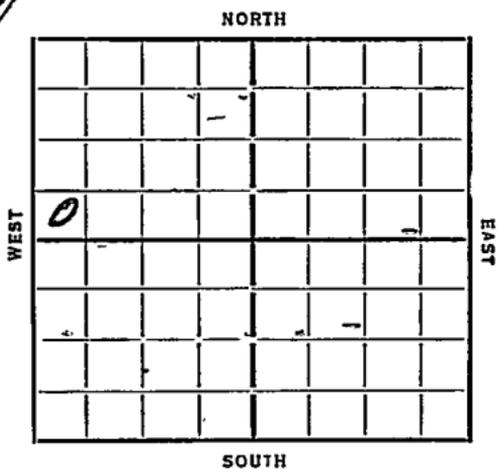

Date	REPORT
1935	O. W. D. D.
6/5	Moving
6/13	Rig
6/20	
6/28	dy 685
7/3	" 1450
7/11	" 2375
7/18	Tarkio 2518-23
	Pay 2520-23
	2000 oil 15 Min
	8" 2517 WOC
7/26	Swab 153 Bbls 4 hrs
	Run rods & tubing
8/8	1000 acid
8/15	P. 109 Bbls oil 6 hrs.
8/23	dy 2705 6" 2583
8/29	6" 2716 @ 2790
9/6	SO 2797-99 6" 2793
	Bailing
10/2	Oswald 3054
	77 3066
	1169 Bbls.

COMPLETED

~~5/20/36\*~~

O. W. D. D

1936-

5/20-Old T.D. 3066'

Cor 3066-93'

300' oil in hole.

5/28-Drlg. 3099'.

6/3/36-P.B. 3078'. T.D. 3099'.

990 oil

207 water

COMPLETED



Map No. 22 Sec. 1 Twp. 14 R. 15W  
 Well No. 1-Erdlich  
Gypsy oil Company  
 Contractor

SECTION PLAT

0			

..... Ft. from N. Line  
330 Ft. from S. Line  
 ..... Ft. from E. Line  
330 Ft. from W. Line

~~COMPLETED~~

Location.....  
 Rig up.....  
 Drilling and Remarks:

1169 bbls

RECORD

Cased..... in., ..... ft.  
 Sand Small 3054  
 Gas.....  
 Oil.....  
 Total Depth 3066

PRODUCTION

1st 24 hrs. Nat.....  
 1st 24 hrs. after shot.....  
 Gas..... Cu. Ft.  
 Dry Hole.....  
 Abandoned.....

Date

10-2-32 192.....

ORVAL MANNSCHRECK

Scout

*Russell*

Map No. 72 Sec. 1 Twp. 14 R. 15W

Well No. 1 Ehrlich

Gulch Company

Contractor

**FIRST REPORTS**

**SECTION PLAT**

\_\_\_\_\_ Ft. from N. Line

330 Ft. from S. Line

\_\_\_\_\_ Ft. from E. Line

330 Ft. from W. Line

0			

OWJIT

Location \_\_\_\_\_

Rig up \_\_\_\_\_

Drilling and Remarks:

Old TIT 3066

@ or 3066-93

300' oil in hole

**RECORD**

Cased \_\_\_\_\_ in., \_\_\_\_\_ ft.

Sand \_\_\_\_\_

Gas \_\_\_\_\_

Oil \_\_\_\_\_

Total Depth \_\_\_\_\_

**PRODUCTION**

1st 24 hrs. Nat. \_\_\_\_\_

1st 24 hrs. after shot \_\_\_\_\_

Gas \_\_\_\_\_ Cu. Ft.

Dry Hole \_\_\_\_\_

Abandoned \_\_\_\_\_

Date

MAY 30 1936

19

S. J. LEWIS

Scout

Map No. 72 Sec. 1 Twp. 14 R. 15WWell No. 1 EhrlichGulf. Company

Contractor

**SECTION PLAT**

6			

\_\_\_\_\_ Ft. from N. Line

330 Ft. from S. Line

\_\_\_\_\_ Ft. from E. Line

330 Ft. from W. Line**COMPLETED** DW 117**RECORD**

Cased \_\_\_\_\_ in., \_\_\_\_\_ ft.

Sand \_\_\_\_\_

Gas \_\_\_\_\_

Oil \_\_\_\_\_

Total Depth 3099**PRODUCTION**

1st 24 hrs. Nat. \_\_\_\_\_

1st 24 hrs. after shot. \_\_\_\_\_

Gas \_\_\_\_\_ Cu. Ft.

Dry Hole \_\_\_\_\_

Abandoned \_\_\_\_\_

Location \_\_\_\_\_

Rig up \_\_\_\_\_

Drilling and Remarks:

P.B. 3078990 Oil207 Water

Date

JUN 3 1936 19S. J. LEWIS Scout