


KANSAS

Russell

Section 1 Township 14 Range 15W

Well No. #5 Dumler

Company Skelly

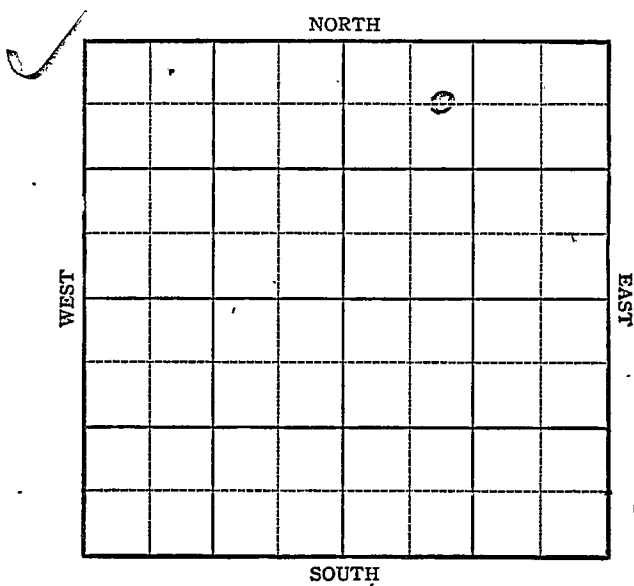

KANSAS

Russell

Sec. 1 Twp. 14 R. 15W

Well No. #5 Dumler Farm

Skelly Company


Big Creek

660 Ft. from N. Line

 Ft. from S. Line

 Ft. from E. Line

990 Ft. from W. Line

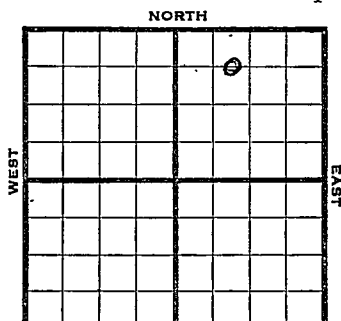

CEL NW NE *Elev. 1888*

1945

R E P O R T

2/14 Location

2/21 Anhy 882
8" @ 887 WOC

2/28 Drlg 1785

3/7 Drlg 2400

3/14 Topeka 2775

Lans 3059

Drlg 3163

3/23 Arb 3309

TD 3315

5" @ 3309' RUST

3/29 " " " "

4/5 " " " "

4/12 " " " "

4/20 1700' oil 10 hrs.

4/25 Arb 3309

5" @ 3309

TD 3315

Pump 92 oil plus 192 wtr. Pot.

Grav. 32.7

COMPLETED

Pool Name Big CreekMap No. K-72 Sec. 1 Twp. 14 R. 15WWell No. 5 DumberSkelly CompanyFIRST REPORT Contractor

C E L NW NE

SECTION PLAT

660 Ft. from N. Line Ft. from S. Line Ft. from E. Line990 Ft. from W. Line

		0	

RussellLocation XRig up

Drilling and Remarks:

RECORD

Cased in., ft.Sand Gas Oil Total Depth

PRODUCTION

1st 24 hrs. Nat. 1st 24 hrs. after shot Gas Cu. Ft.Dry Hole Abandoned

Date

FEB 14 1945 19

S. J. LEWIS Scout


Kansas Pool Name Big CreekMap No. 72 Sec. 1 Twp. 14 R. 15WWell No. 5 DumlerSkelly

Company

COMPLETED

Contractor

C EL NW NE

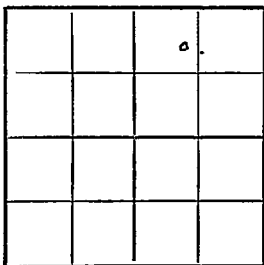E. 1888
SECTION PLAT660 Ft. from N. Line Ft. from S. Line Ft. from E. Line990 Ft. from W. Line

Russell

RECORDLocation Cased in., ft.Rig up Sand

Drilling and Remarks:

Gas Oil Total Depth 3315**PRODUCTION**1st 24 hrs. Nat. 1st 24 hrs. after shot Gas Cu. Ft.Dry Hole Abandoned

Date

APR 25 1945

19

S. J. LEWIS

Scout

32 2 1/2

Cr 3309
8" 3309
Pump 92 oil +
192 Water 3309