

Russell

KANSAS

Section 1 Township 14 Range 15-W

Well Number 1 Dumbler


Company Texas

NORTH

WEST

EAST

SOUTH

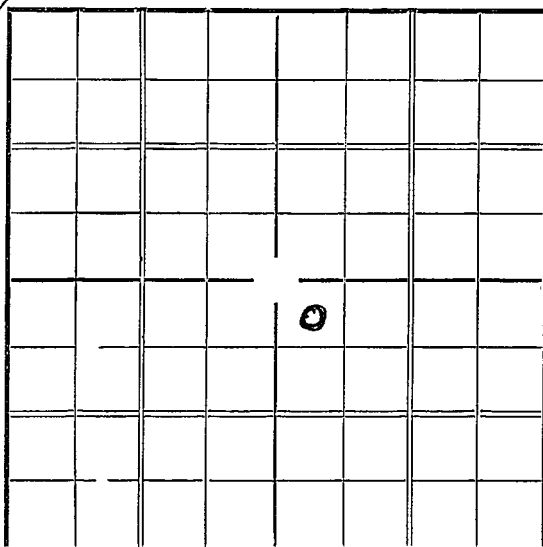

KANSAS

Russell

Map No. _____ Sec. 1 Twp. 14 R. 15-WWell No. #1 Dumbler Farm _____

_____ Texas _____ Company _____


330 Ft. from N. Line

_____ Ft. from S. Line

_____ Ft. from E. Line

330 Ft. from W. Line

Elev. 1874

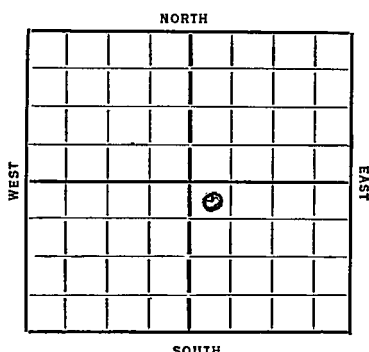Date
1936

REPORT

12/22 R O G

12/29 Rig.

1937

1/7 15" @ 318'. Drlg. 390'.

1/14 Anhydrate 913'. 10" @ 922' Drlg.

1/21 Drlg. 1775'.

1/28 Drlg. 2415'.

2/4 Topeka 2770 Show of oil at
2770-74, 2785-90, Show oil
 $\frac{1}{2}$ bailer water 2945 Drlg. 3010

2/11 Lansing 3046 Set 7" Show Oil
3048 T.D. 3110, 2600' oil in hole

2/17 Lansing 3046'.

T. D. 3110'.

1000 acid.

Potential 848.

COMPLETED

KANSAS

Map No. 72 Sec. 1 Twp. 14 R. 15WWell No. 1 Turner/EETexas. Company _____

Contractor _____

SECTION PLAT

		0	

330 Ft. from N. Line

_____ Ft. from S. Line

_____ Ft. from E. Line

330 Ft. from W. Line

FIRST REPORT

Location _____

Rig up _____

Drilling and Remarks:

ROG

RECORD

Cased _____ in., _____ ft.

Sand _____

Gas _____

Oil _____

Total Depth _____

PRODUCTION

1st 24 hrs. Nat. _____

1st 24 hrs. after shot _____

Gas _____ Cu. Ft.

Dry Hole _____

Abandoned _____

Date
DEC 22 1936

19

S. J. LEWIS

Scout

Map No. 72 Sec. 1 Twp. 14 R. 15W

Well No. 1 Hammer

Texas Company

Contractor

SECTION PLAT

		0	

330 Ft. from N. Line

_____ Ft. from S. Line

_____ Ft. from E. Line

330 Ft. from W. Line

COMPLETED

RECORD

Location _____

Rig up _____

Drilling and Remarks:

Lansing 3046

1006 acid

Potential

848

Cased _____ in., _____ ft.

Sand _____

Gas _____

Oil _____

Total Depth 3110

PRODUCTION

1st 24 hrs. Nat. _____

1st 24 hrs. after shot _____

Gas _____ Cu. Ft.

Dry Hole _____

Abandoned _____

Date

FEB 17 1937 19

S. J. LEWIS Scout