


Section 1 Township 14 Range 15-W


Well Number 4 - Dumbler

Company Skelly

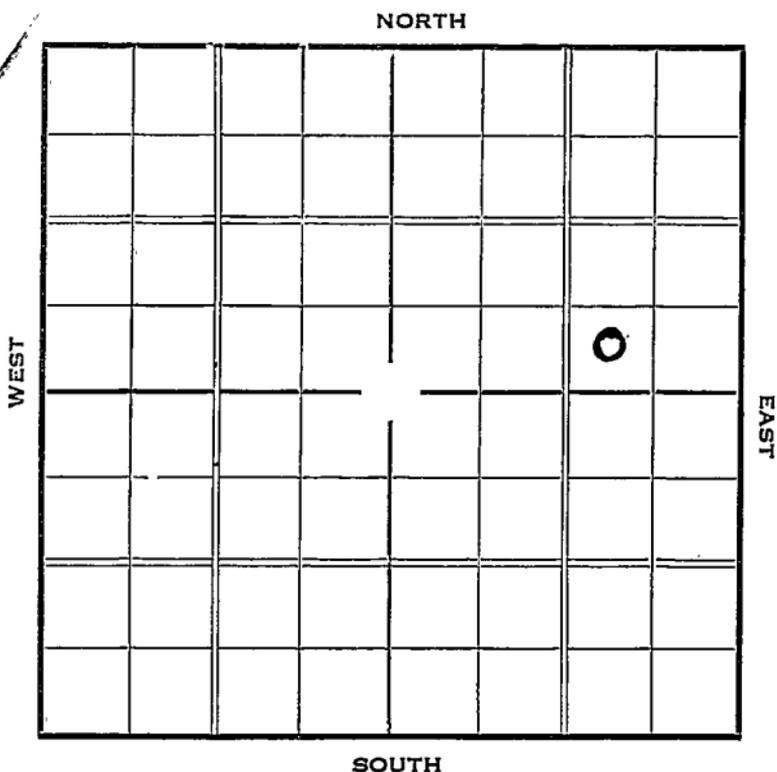

Sec. 1 Twp. 14 R. 15-WWell No. #4 Dumbler FarmSkelly Company Ft. from N. Line330 Ft. from S. Line990 Ft. from E. Line Ft. from W. Line

Elev. 1876

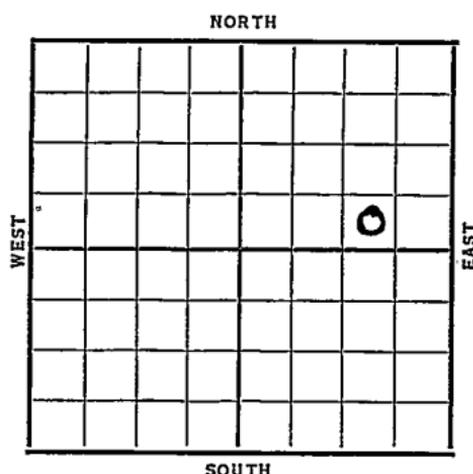

Date	REPORT
1937	
5/19	Material
5/28	T.D. 411' Reaming.
6/4	12" @ 411'. Drlg. 1920'.
6/11	Topeka 2765'. S.O. 2766-68'
	T.D. 2770'. Rng. 8".
6/19	8" @ 2766'. RUST.
6/25	" " "
7/2	Drlg. 2875'.
7/9	6" @ 3058'. Drlg. 3080'.
7/16	T.D. 3180'. U. R. 6".
7/23	6" @ 3166'. Sil. 3328 3328'.
	T.D. 3290'. Small S.O. 3290'
	U.R. 6".
7/30	6" @ 3287'. ½ bailer oil
	P.H. @ 3302-07½'.
	Gorham 3303'. Sil. 3309'.
	T.D. 3323'. C.O.
8/6	Reaming 6".
8/13	6" @ 3306'. T.D. 3316' WOC.
	OVER

1937

8/20 1700' water 3309-16' T.D.

Plugging back to Topeka.

8/28 P.B. 2773'.

9/1 6" @ 3306'.

Sil. 3309' (Corrected)

T.D. 3323' H.F.W.

P.B. 2773'.

Shot W/90 shots.

3000 acid & 6000. .

. No help.

ABANDONED

Russell KANSAS

Map No. 72 Sec. 1 Twp. 14 R. 15^W

Well No. 4 - Dumbler

Spelly Company
Contractor

FIRST REPORT

SECTION PLAT

 Ft. from N. Line
330 Ft. from S. Line
990 Ft. from E. Line
 Ft. from W. Line

			0

Location _____

Rig up _____

Drilling and Remarks:

Material

RECORD

Cased _____ in., _____ ft.

Sand _____

Gas _____

Oil _____

Total Depth _____

PRODUCTION

1st 24 hrs. Nat. _____

1st 24 hrs. after shot _____

Gas _____ Cu. Ft.

Dry Hole _____

Abandoned _____

Date

MAY 19 1937

H. D. Hatfield

Scout

Russell KANSAS

Map No. _____ Sec. 1 Twp. 14 R. 15^WWell No. 4 - DumblerSkelly Company

Contractor

ABANDONED

SECTION PLAT

			0

100 Ft. from N. Line330 Ft. from S. Line990 Ft. from E. Line

_____ Ft. from W. Line

Location _____

Rig up: _____

Drilling and Remarks:

P.B. 2773

SHOT w/90 shots

3000 Acid & 6000

No help

DVA

RECORD

Cased 6 in. 3306 ft.Sand 511 3309Gas (corrected)

Oil _____

Total Depth 3323

PRODUCTION

1st 24 hrs. Nat. _____

1st 24 hrs. after shot _____

Gas _____ Cu. Ft.

Dry Hole _____

Abandoned _____

Date

SEP 1 1937 19

H. D. Hatfield Scout