
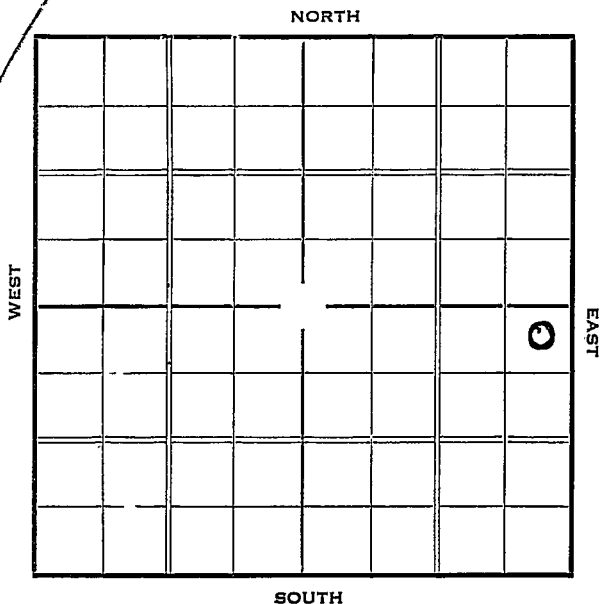


Section.....1.....Township.....14.....Range.....15-~~W~~

Well Number.....#4 Dumbler.....

Company.....Texas.....

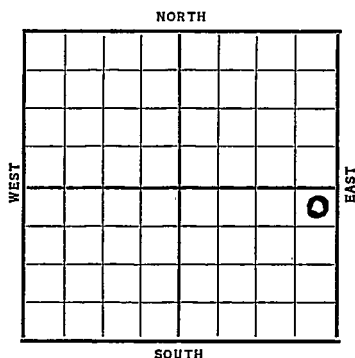

Sec. 1 Twp. 14 R. 15-WWell No. #4 Dumbler FarmTexas Company330 Ft. from N. Line Ft. from S. Line330 Ft. from E. Line Ft. from W. Line

Date	REPORT
1937	
6/30	Cellar
7/9	R. U.
7/16	15" @ 338'. Drlg. 340'.
7/23	12" @ 607'. 10" @ 215'.
	Drlg. 1460'.
7/30	Drlg. 2495'.
8/6	Topeka 2775'. 6" @ 2735'. T.D. 2940'
	H.F.O. 10 Min.
8/11	6" @ 2735'.
	Topeka 2775'.
	T.D. 2942'.
	Pot. 3048 bbls. Nat.
	Pump & flow.
	COMPLETED

Russell KANSAS

Map No. _____ Sec. 1 Twp. 14 R. 15^WWell No. 4-DumblerTexas Company

Contractor

FIRST REPORT

SECTION PLAT

330 Ft. from N. Line

_____ Ft. from S. Line

330 Ft. from E. Line

_____ Ft. from W. Line

			0

Location _____

Rig up _____

Drilling and Remarks:

Cellar

RECORD

Cased _____ in., _____ ft.

Sand _____

Gas _____

Oil _____

Total Depth _____

PRODUCTION

1st 24 hrs. Nat. _____

1st 24 hrs. after shot _____

Gas _____ Cu. Ft.

Dry Hole _____

Abandoned _____

Date

JUN 30 1937 19

H. D. Hatfield

Scout

Russell KANSAS

Map No. _____ Sec. 1 Twp. 14 R. 15 W.Well No. 4 - DumblerTexas Company

Contractor

COMPLETED

330 Ft. from N. Line

_____ Ft. from S. Line

330 Ft. from E. Line11 Ft. from W. Line

SECTION PLAT

			0

Location _____

Rig up _____

Drilling and Remarks:

Pot - 3048

Nat

Pump & Flow

RECORD

Cased 6 in., 2735 ft.Sand Topeka 2775

Gas _____

Oil _____

Total Depth 2942

PRODUCTION

1st 24 hrs. Nat. _____

1st 24 hrs. after shot _____

Gas _____ Cu. Ft.

Dry Hole _____

Abandoned _____

Date

AUG 11 1937₁₉

H. D. Hatfield Scout