


RUSSELL

KANSAS

Section 1 Township 14 Range 15WWell Number #2 ~~5~~ DumblerCompany Skelly

NORTH

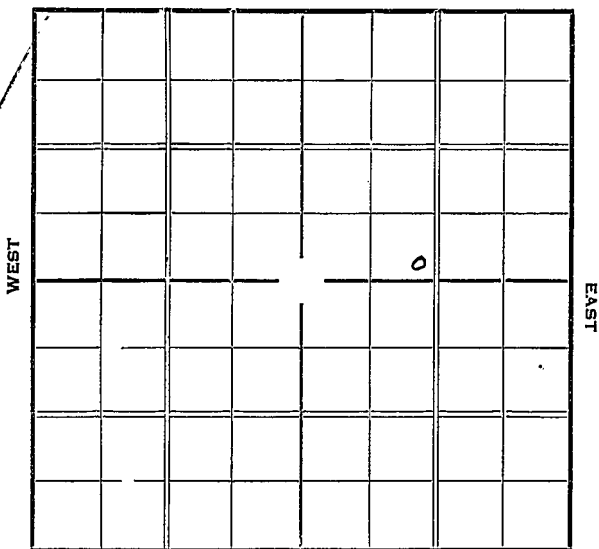

SOUTH

Sec. 1 Twp. 14 R. 15-W

Well No. ~~3~~⁴ Dumbler Farm

Skelly _____ Company


Ft. from N. Line

330 Ft. from S. Line

Ft. from E. Line

990 Ft. from W. Line

Elev. 1879

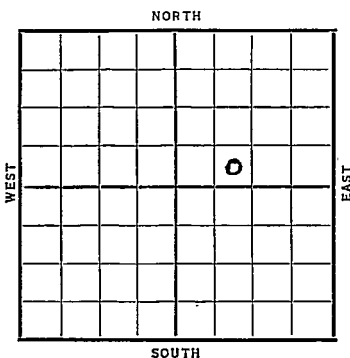[illegible]

Russell KANSAS

Map No. 72 Sec. 1 Twp. 14 R. 15WWell No. 3 DummerShelby Company

Contractor

SECTION PLAT

		0	

 Ft. from N. Line320 Ft. from S. Line Ft. from E. Line990 Ft. from W. Line

FIRST REPORT

Location ✓Rig up

Drilling and Remarks:

RECORD

Cased in., ft.Sand Gas Oil Total Depth

PRODUCTION

1st 24 hrs. Nat. 1st 24 hrs. after shot Gas Cu. Ft.Dry Hole Abandoned

Date

13 1937

19

S. J. LEWIS

Scout

Map No. 72 Sec. 1 Twp. 14 R. 15W.

Well No. 2. Dumber

Shelby Oil Company
Contractor

SECTION PLAT

		0	

 Ft. from N. Line

230 Ft. from S. Line

 Ft. from E. Line

990 Ft. from W. Line

CORRECTION

Location

Rig up

Drilling and Remarks:

*Reported as
No 3*

RECORD

Cased in., ft.

Sand

Gas

Oil

Total Depth

PRODUCTION

1st 24 hrs. Nat.

1st 24 hrs. after shot

Gas Cu. Ft.

Dry Hole

Abandoned

Date

JAN 27 1937

19

S. J. LEWIS

Scout

Map No. 72 Sec. 1 Twp. 14 R. 15WWell No. 2 TurnerShelly Company

Contractor

SECTION PLAT

		0	

 Ft. from N. Line330 Ft. from S. Line Ft. from E. Line990 Ft. from W. Line

COMPLETED

Location Rig up

Drilling and Remarks:

Topeka 27722000 a cilPotential1801

RECORD

Cased in., ft.Sand Gas Oil Total Depth 2775

PRODUCTION

1st 24 hrs. Nat. 1st 24 hrs. after shot Gas Cu. Ft.Dry Hole Abandoned

Date

MAR 3 1937₁₉

S. J. LEWIS

Scout