


Section 1 Township 14 Range 15 W

Well No. # 13 C. Anschutz

Company Texas

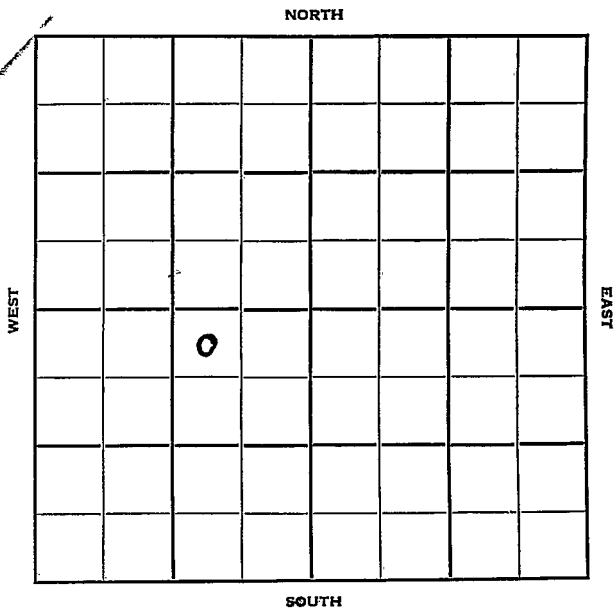

Russell KANSAS



Sec. 1 Twp. 14 R. 15 W

Well No. # 13 C. Anschutz Farm

Texas Company

Anschutz Contractor
Gorham


340 Ft. from N. Line

_____ Ft. from S. Line

980 Ft. from E. Line

_____ Ft. from W. Line

NW NE SW

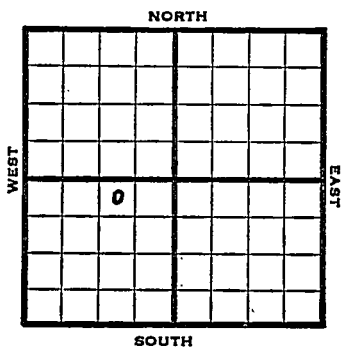

1952

Elev. 1873' REPORT

5/28

Spud 5-21-52
8" @ 919
Drlg. 2432'

6/11

Arb. 3289' TD 3293' 5" @ 3292'
CO 3293' VSSO DD 3294' TD
S/24 BOPH POP

6/18

NR

6/25

Spud 5-21-52
Oil Well TD 3294' 8" @ 919
Arb. 3289 TD 3293 5" @ 3292
CO to 3293 DD 3294 S/ 24 boph
Comp. 118 bopd 18 bw

COMPLETED

