


Section 1 Township 14 Range 15W

Well No. #9 Anschutz

Company Texas

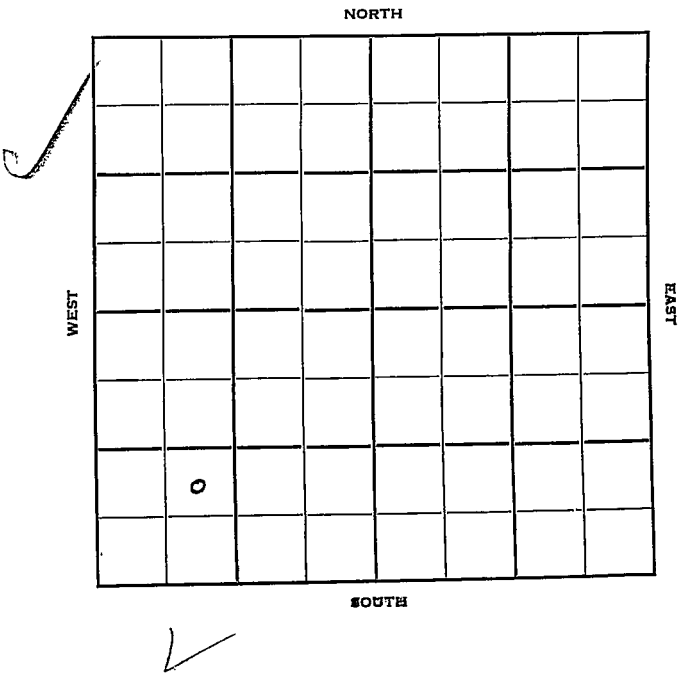

Russell

KANSAS

Sec. 1 Twp. 14 R. 15W ✓

Well No. #9 Anschutz Farm

Texas Company

Contractor

Gorham Pool


 Ft. from N. Line

990' Ft. from S. Line

 Ft. from E. Line

990' Ft. from W. Line

NE SW SW

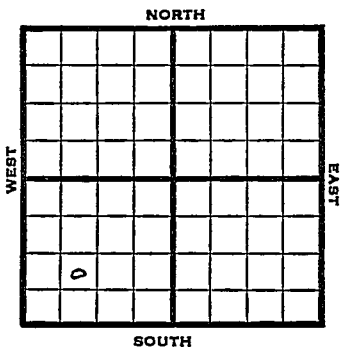

1950

Elev. 1877' REPORT

10/18

Location

12/13

Spud 11-10-50

Oil Well TD 3297

13" @ 785' Cored 2765-71

Rec. 4' pr lime SS0

DST 2763-71 opn 1 hr

Rec. 30' mud & wtr

DST 2934-60 opn 1 hr

Rec. 45' socm Granite sd 3294-97 TD

7" @ 3294 FU 880' oil 6 hr

P/86 bo 14 hr

Comp. 95 bopd

COMPLETED

County **Russell** State **Kansas**

Sec. 1 (Blk. 14) (Sur. 15W) Map No. _____
(Twp. _____) (Rge. _____)

Operator **Texas**

Well No. 9 Farm Anschutz

Elev.	Location	NE	SW	SW
-------	----------	----	----	----

0

FIRST REPORT

990 Ft. From S Line SW

990 Ft. From W Line Quarter

1st. Report OCT 18 1950

Completion

Remarks


Spudding Date

Drig. Data Gorham Pool

Location

J. E. TYRA

County Russell State Kansas
 Sec. 1 (Blk.
Twp.) 14 (Sur.
Rge.) 15W Map No.
 Operator Texas Company
 Well No. 9 Farm Anschutz
 Elev. 1877 Location NE SW SW

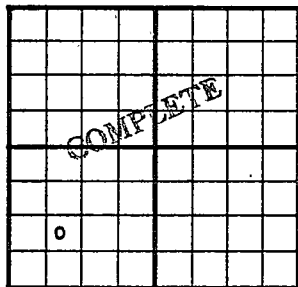

990 Ft. From S Line SW
990 Ft. From W Line Quarter
 Ist. Report
 Completion DEC 13 1950
 Remarks Gorham Pool
 Spudding Date 11-10-50

Drig. Data Oil well TD 3297
13" @ 785 Cored 2765-71 Rec. 4' por.
lime SSO DST 2763-71 open 1 hr.
Rec. 30' mud & water DST 2934-60
open 1 hr. Rec. 45' socm Granite sd. 3294
-97 TD 7" @ 3294 FU 880' oil 6 hr.
P/ 86 bo 14 hr.
Comp. 95 bopd

J. E. TYRA