


*Kansas* Russell

FORM 51 5M 1-42 PETROL

Section 1 Township 14 Range 15-W

Well No. #8 Anschutz

Company Texas

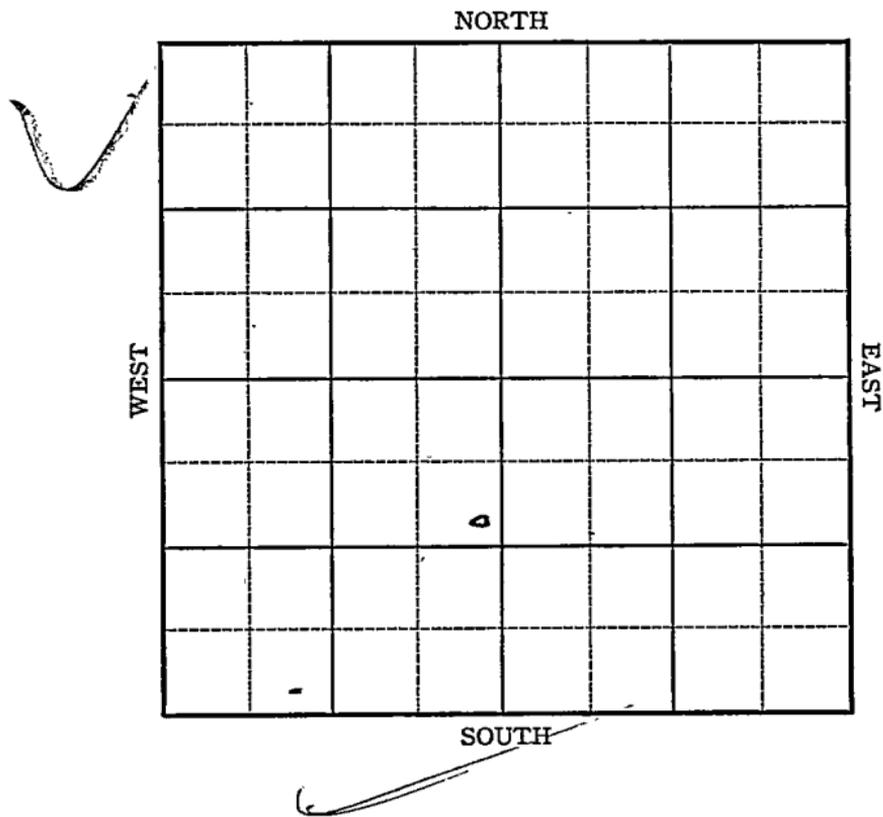

KANSAS

Russell

Sec. 1 Twp. 14 R. 15-W

Well No. #8 Anschutz Farm

Texas

Company


Trapp

1102 Ft. from N. Line

\_\_\_\_\_ Ft. from S. Line

40 Ft. from E. Line

\_\_\_\_\_ Ft. from W. Line

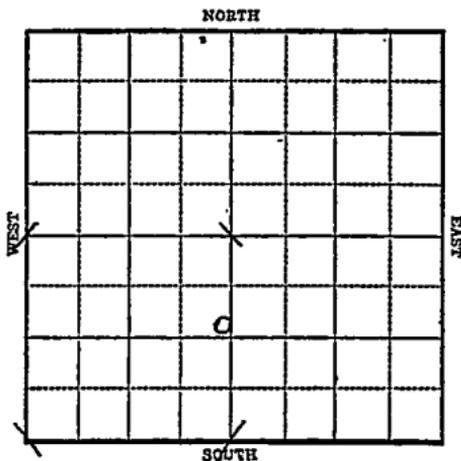

1943

R E P O R T

3/24 Location  
S.W.D.

3/31 7" @ 586'  
SWD  
T.D. 875

**ABANDONED**

Russell

KANSAS

Map No. 72 Sec. 1 Twp. 14 R. 15W

Well No. 8 Anschutz

Texas Company

FIRST REPORT Contractor

SE NE SW


SECTION PLAT

1102 Ft. from N. Line

\_\_\_\_\_ Ft. from S. Line

40 Ft. from E. Line

\_\_\_\_\_ Ft. from W. Line

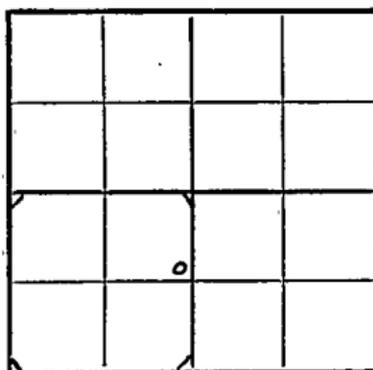

TRAPP POOL

Location XXX

Rig up \_\_\_\_\_

Drilling and Remarks:

S.W.D.

RECORD

Cased \_\_\_\_\_ in., \_\_\_\_\_ ft.

Sand \_\_\_\_\_

Gas \_\_\_\_\_

Oil \_\_\_\_\_

Total Depth \_\_\_\_\_

PRODUCTION

1st 24 hrs. Nat. \_\_\_\_\_

1st 24 hrs. after shot \_\_\_\_\_

Gas \_\_\_\_\_ Cu. Ft.

Dry Hole \_\_\_\_\_

Abandoned \_\_\_\_\_

Date

MAR 24 1943 19

S. J. LEWIS Scout

Russell

**KANSAS**  
 Map No.        Sec. 1 Twp. 14 R. 15W

Well No. 8 Anschutz

Texas

Company

~~COMPLETED~~

Contractor

SE NE SW

*Abandoned*

## SECTION PLAT

1102 Ft. from N. Line

\_\_\_\_\_ Ft. from S. Line

40 Ft. from E. Line

\_\_\_\_\_ Ft. from W. Line


## TRAP P POOL

Location \_\_\_\_\_

Rig up \_\_\_\_\_

Drilling and Remarks:

*7" C 586**BWJ*

## RECORD

Cased \_\_\_\_\_ in., \_\_\_\_\_ ft.

Sand \_\_\_\_\_

Gas \_\_\_\_\_

Oil \_\_\_\_\_

Total Depth 875

## PRODUCTION

1st 24 hrs. Nat. \_\_\_\_\_

1st 24 hrs. after shot \_\_\_\_\_

Gas \_\_\_\_\_ Cu. Ft.

Dry Hole \_\_\_\_\_

Abandoned \_\_\_\_\_

Date

MAR 31 1943 19

S. J. LEWIS Scout