


Section 1 Township 14 Range 15-W

Well Number #5 Anschutz

Company Texas Oil

NORTH

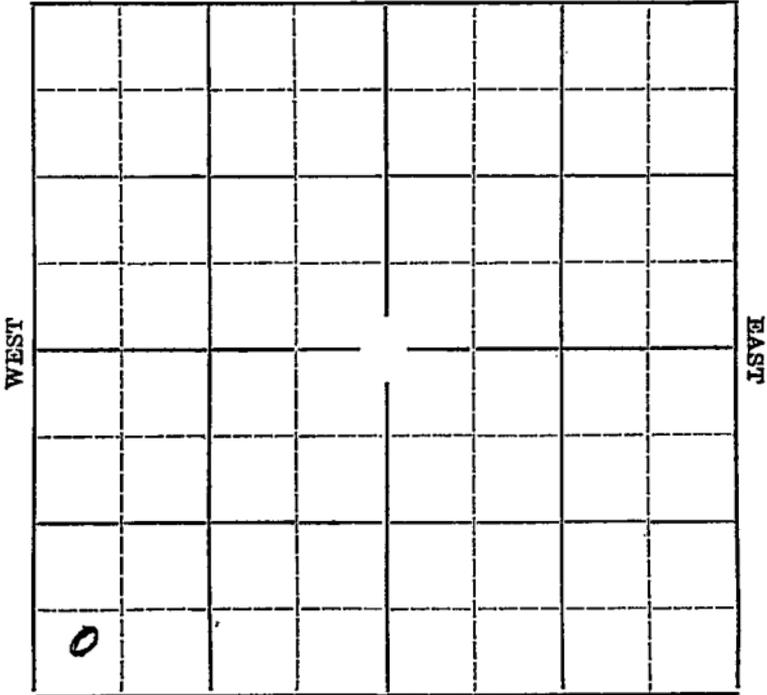


SOUTH



Sec. 1 Twp. 14 R. 15WWell No. #5 Anschutz FarmTexas Oil Co. Company

NORTH

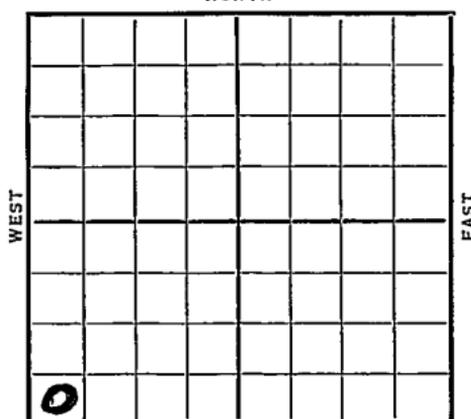

Ft. from N. Line

330' Ft. from S. Line

Ft. from E. Line

330' Ft. from W. Line

Elev. 1879

SOUTH

19 <u>26</u>	REPORT
10/14	Location.
10/22	--
10/29	Rig.
11/6	Rigging up
11/12	15" @ 395' Drlg. 420.
11/19	Anhydrate 895'. 10" @ 905' Drlg. 1680'.
11/27	8" @ 2495'. Shut down.
12/3	Topeka 2760'. Oswald 3037'. 7" @ 3038'. Drlg. 3210'.
12/10	T. D. 3297'. Hole full water. Plug back 3280'. Clean out.
12/17	5" @ 3308'. Sil. 3296'. Drlg. 3315'.
12/24	Drlg. 3398'.
12/29	Gorham 3304'. Granite 3390'. T. D. 3394 will plug back.
1937	
1/7	P. B. to 3150'. 200 acid. swab 2 bbls oil 2 water per hour.

OVER

1937

1/14 Pump 17½ oil 42 water 4 hrs.

1/21 Pump 8 oil 8 water 4 hrs.

1/28 " " " "

2/3 Granite 3390'.

T. D. 3394'.

P.B. 3125'.

Pump 15 bbls.

COMPLETED

Map No. 72 Sec. 1 Twp. 14 R. 15W

Well No. 5 Anschutz

Texas Oil Company

Contractor

SECTION PLAT

_____ Ft. from N. Line

330 Ft. from S. Line

_____ Ft. from E. Line

380 Ft. from W. Line

FIRST REPORT

Location ✓

Rig up _____

Drilling and Remarks:
1

RECORD

Cased _____ in., _____ ft.

Sand _____

Gas _____

Oil _____

Total Depth _____

PRODUCTION

1st 24 hrs. Nat. _____

1st 24 hrs. after shot _____

Gas _____ Cu. Ft.

Dry Hole _____

Abandoned _____

Date

OCT 14 1936 19

S. J. LEWIS Scout

Russell
Map No. 72 Sec. 1 Twp. 14 R. 15W

Well No. 5 Cuscutz

Texas Company

Contractor

SECTION PLAT

0			

_____ Ft. from N. Line

330 Ft. from S. Line

_____ Ft. from E. Line

330 Ft. from W. Line

COMPLETED

RECORD

Location _____

Cased _____ in., _____ ft.

Rig up _____

Sand _____

Drilling and Remarks:

Gas _____

Granite 3390

Oil _____

Total Depth 3394

P.B. 3125

PRODUCTION

1st 24 hrs. Nat. _____

1st 24 hrs. after shot _____

Gas _____ Cu. Ft.

Dry Hole _____

Abandoned _____

Date

FEB 3 1937

19

713

Scout