


Section 1 Township 14 Range 15W

Well No. #11 Anschutz

Company Texas Co.

NORTH

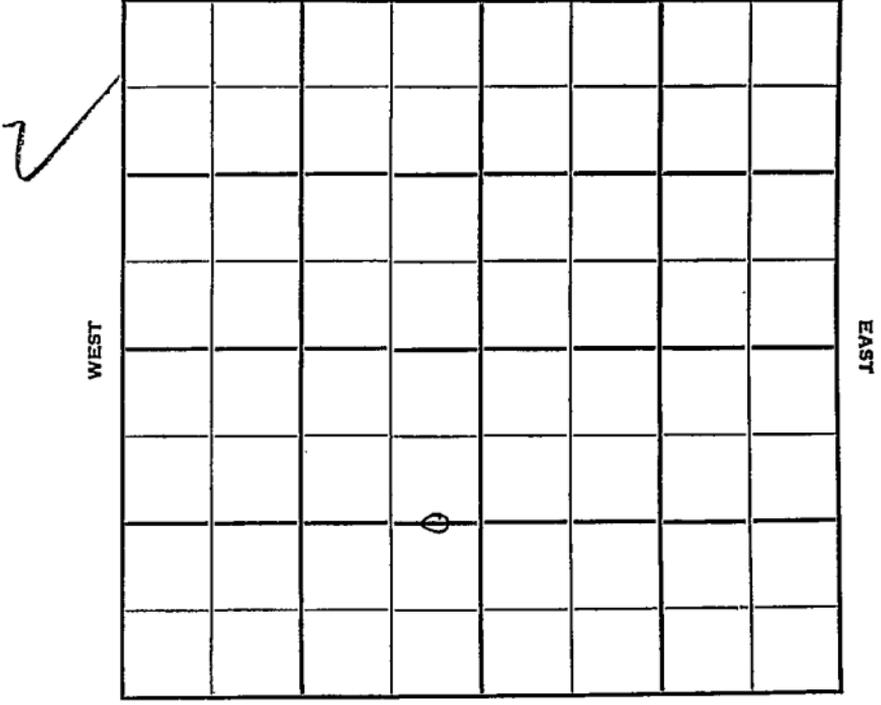

WEST

EAST

SOUTH

Russell

KANSAS

Sec. 1 Twp. 14 R. 15 W

Well No. # 11 Anschutz Farm

Texas Company Company

Contractor

Gorham Pool


Ft. from N. Line

1320 Ft. from S. Line

330 Ft. from E. Line

Ft. from W. Line

C E L $E\frac{1}{2}$ SW

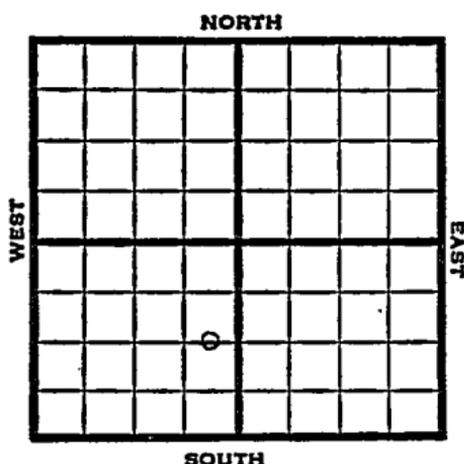

1951

Elev. 1865' REPORT

8/29

Location

12/12

SWD WELL TD 3379'

13" @ 855

Top. 2749 Heeb. 2977

Lans. 3030 Gorham 3285

Granite 3365

7" @ 3320 TD 3379

S/ 20 BWPB 2000 A

Comp. for SWD well

Input 4 BSW PER min.

Abandoned

ABANDONED


County **Russell** State **Kansas**

Sec. **1** (Blk. Twp.) **14** (Sur. Rge.) **15W** Map No.

Operator **Texas Company**

Well No. **11** Farm **Anschutz**

Elev. Location **C E L E 1/2 SW**

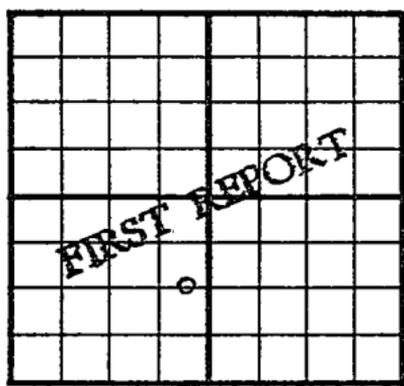

1320 Ft. From **S** Line **SW**

330 Ft. From **E** Line Quarter

Ist. Report **AUG 29 1951**

Completion

Remarks

Spudding Date

Drlg. Data **Gorham Pool**

Location

J. E. TYRA


County Russell State Kansas

Sec. 1 (Blk. Twp.) 14 (Sur. Rge.) 15W Map No.

Operator Texas Company

Well No. 11 Farm Anschutz

Elev. 1865 Location C E L E $\frac{1}{2}$ SW

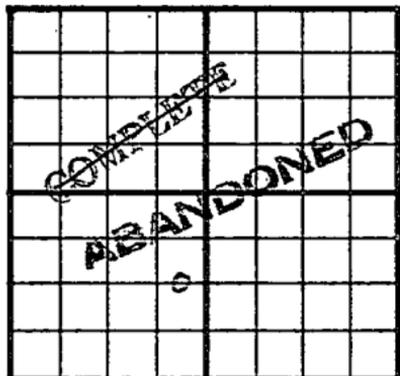

1320 Ft. From S Line SW

330 Ft. From E Line Quarter

Ist. Report

Completion DEC 1 2 1951

Remarks Gorham Pool

Spudding Date

Drlg. Data SWD well TD 3379

13" @ 855 Top. 2749 Heeb. 2977

Lans. 3030 Gorham 3285 Granite 3365

7" @ 3320 TD 3379 S/ 20 bwph 2000 A

Comp. for SWD well Input 4 bsw per min.

J. E. TYRA