


Section 1 Township 14 Range 15W

Well Number 2 Dumbler

Company Texas

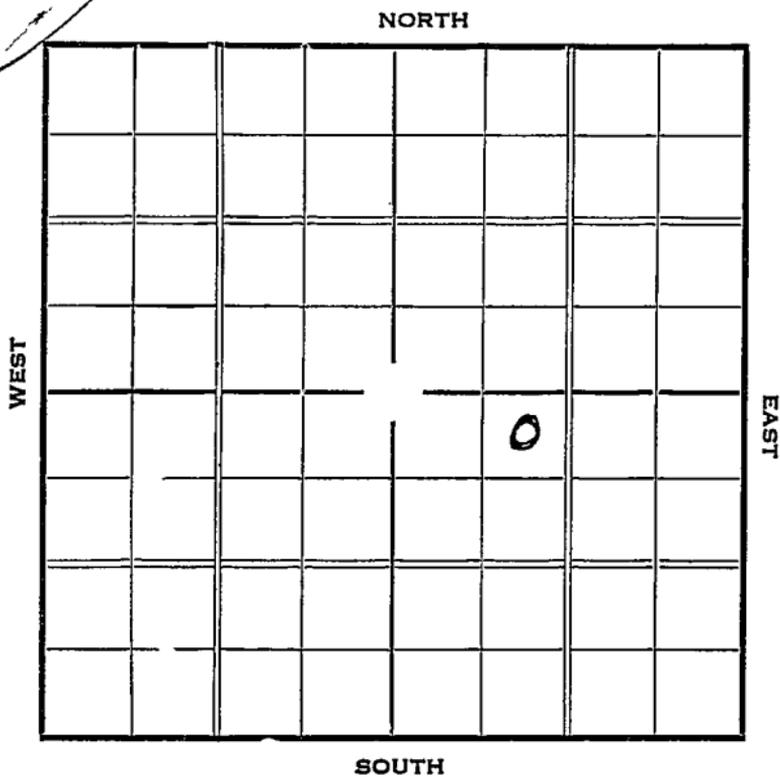

Sec. 1 Twp. 14 R. 15-W

Well No. #2 Dumbler Farm

Texas Company


330 Ft. from N. Line

_____ Ft. from S. Line

_____ Ft. from E. Line

990 Ft. from W. Line

Elev. 1877

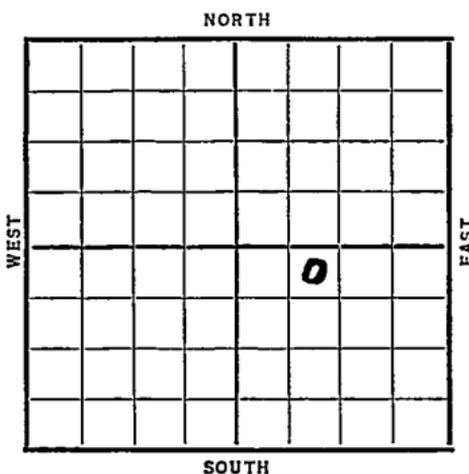

Date	REPORT
1937 2/17	Location
2/26	Rigging up.
3/4	15" @ 320'. Drlg. 435'.
3/11	10" @ 914' Drlg. 1055'.
3/18	Anhydrate 907'. Drlg 2235'.
3/25	Drlg. 2710'.
4/2	Oswald 3050'. 3052' under ream 6"
4/8	T.D. 3110' - 1000 acid.
	Pump 329 bbls 24 hrs.
4/14	Oswald 3052'.
	T.D. 3110'.
	3000 acid.
	Potential 736 oil, 150 water.
	COMPLETED

Map No. 72 Sec. 1 Twp. 14 R. 15W

Well No. 2. Hunter

Texas. Company

Contractor

SECTION PLAT

		0	

300 Ft. from N. Line

_____ Ft. from S. Line

_____ Ft. from E. Line

990 Ft. from W. Line

FIRST REPORT

Location ✓

Rig up _____

Drilling and Remarks:

RECORD

Cased _____ in., _____ ft.

Sand _____

Gas _____

Oil _____

Total Depth _____

PRODUCTION

1st 24 hrs. Nat. _____

1st 24 hrs. after shot _____

Gas _____ Cu. Ft.

Dry Hole _____

Abandoned _____

Date

FEB 17 1937 19 _____

S. J. LEWIS Scout

Map No. _____ Sec. 1 Twp. 14 R. 15WWell No. 2. DummerHexas Company

Contractor _____

SECTION PLAT

		o	

330 Ft. from N. Line

_____ Ft. from S. Line

_____ Ft. from E. Line

990 Ft. from W. Line

COMPLETED

Location _____

Rig up _____

Drilling and Remarks:

*Oswald 3052**3000 acid**Potential**736 oil 150 water*

RECORD

Cased _____ in., _____ ft.

Sand _____

Gas _____

Oil _____

Total Depth 3110

PRODUCTION

1st 24 hrs. Nat. _____

1st 24 hrs. after shot _____

Gas _____ Cu. Ft.

Dry Hole _____

Abandoned _____

Date

APR 14 1937 19

S. J. LEWIS Scout