

KANSAS Kansas Pool Name Wildcat  
Map No. 36 Sec. 19 Twp. 14 R. 10W  
Well No. 1 Cook "B"

Kansas  
Map No. 36 Sec. 19 Twp. 14 R. 10W  
Well No. 1 Cook "B"


Cities Service Company  
**FIRST REPORT** Contractor

Cities Service Company  
**ABANDONED** Contractor

NE SW

SECTION PLAT

330 Ft. from N. Line  
Ft. from S. Line  
480 Ft. from E. Line  
Ft. from W. Line

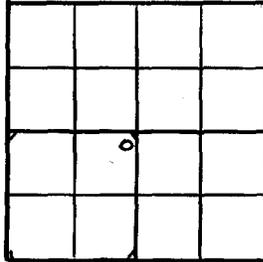

Ellsworth County

Location \_\_\_\_\_  
Rig up \_\_\_\_\_  
Drilling and Remarks:  
  
R U R

**RECORD**  
Cased \_\_\_\_\_ in., \_\_\_\_\_ ft.  
Sand \_\_\_\_\_  
Gas \_\_\_\_\_  
Oil \_\_\_\_\_  
Total Depth \_\_\_\_\_


**PRODUCTION**  
1st 24 hrs. Nat. \_\_\_\_\_  
1st 24 hrs. after shot \_\_\_\_\_  
Gas \_\_\_\_\_ Cu. Ft.  
Dry Hole \_\_\_\_\_  
Abandoned \_\_\_\_\_

Date  
OCT 2 1946 19 S. J. LEWIS Scout

NE SW

SECTION PLAT

330 Ft. from N. Line  
Ft. from S. Line  
480 Ft. from E. Line  
Ft. from W. Line

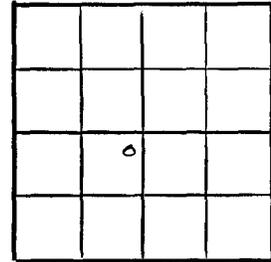

Ellsworth County

Location \_\_\_\_\_  
Rig up \_\_\_\_\_  
Drilling and Remarks:  
  
*Part 8/87*  
*5103077*

**RECORD**  
Cased \_\_\_\_\_ in., \_\_\_\_\_ ft.  
Sand \_\_\_\_\_  
Gas \_\_\_\_\_  
Oil \_\_\_\_\_  
Total Depth 9122

**PRODUCTION**  
1st 24 hrs. Nat. \_\_\_\_\_  
1st 24 hrs. after shot \_\_\_\_\_  
Gas \_\_\_\_\_ Cu. Ft.  
Dry Hole \_\_\_\_\_  
Abandoned \_\_\_\_\_

Date  
NOV 13 1946 19 S. J. LEWIS Scout

Sec. 19 Twp. 14 R. 10-W

Well No. #1, Cook "B" Farm \_\_\_\_\_

Cities Service Oil Company Company

Wildcat


330' Ft. from N. Line

\_\_\_\_\_ Ft. from S. Line

480' Ft. from E. Line

\_\_\_\_\_ Ft. from W. Line

**NE SW**

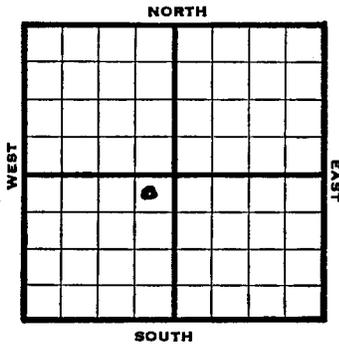

1946 1671 REPORT

- 10/2 R U R
- 10/8 Anhy 455'  
8" @ 475  
Drlg 1525'
- 10/15 Mans 2775'  
Drlg 2898'
- 10/22 Cong 3 135'  
Arb 3139'  
TD3177  
5" @ 3074, RUST
- 10/29 " " "
- 11/6 " " "
- 11/13 Arb 3139'  
5" @ 3074'  
TD 3177'

**ABANDONED**

Section 19 Township 14 Range 10-W

Well No. #1, Cook "B"

Company Cities Service Oil Company

