

County **Ellsworth** State **Kansas**

Sec. **28** (Blk. Twp.) **14** (Sur. Rge.) **10W** Map No.

Operator **W. H. Pool**

Well No. **1** Farm **Kepka**

Elev. Location **SE SE NW**

FIRST REPORT	

330 Ft. From **S** Line **NW**

330 Ft. From **E** Line Quarter

1st. Report **OCT 3 1951**

Completion

Remarks **Gt. Lakes farmout**

Spudding Date **9-28-51**

Drlg. Data

8" @ 286 drlg. 2115

J. E. TYRA

County **Ellsworth** State **Kansas**

Sec. **28** (Blk. Twp.) **14** (Sur. Rge.) **10W** Map No.

Operator **W. H. Pool**

Well No. **1** Farm **Kepka**

Elev. **1651** Location **SE SE NW**

330 Ft. From S Line NW	
330 Ft. From E Line Quarter	
1st. Report	
Completion OCT 10 1951	
Remarks	
Spudding Date 9-28-51	

ABANDONED

Drlg. Data

D & A**TD 3300****8" @ 286 Anhy 475 Heeb. 2704****Lans. 2821 Cong. 3175 Arb. 3279****TD 3300****D & A**

J. E. TYRA

Ellsworth

KANSAS

Sec. 28 Twp. 14 R. 10W

Well No. #1 Kepka Farm

W. H. Pool Company

Contractor

Ft. from N. Line


330 Ft. from S. Line

330 Ft. from E. Line

Ft. from W. Line

SE
SW SE NW

Gt. Laeks Farmout

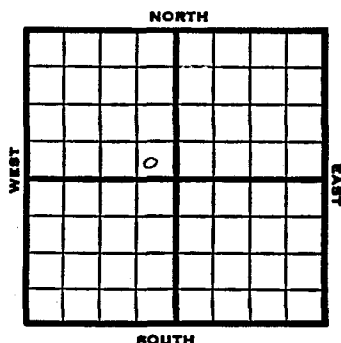

1951 Elev. 1651' REPORT

10/3 Spud 9-28-51
8" @ 286
Drlg. 2115'

10/10 Spud 9-28-51
D&A TD 3300
8" @ 286
Anhy 475 Heeb. 2704
Lans. 2821 Cong. 3175
Arb. 3279
TD 3300 D&A

ABANDONED

Section 28 Township 14 Range 10 W

Well No. # 1 Kepka

Company W. H. Pool

