

Map No. _____ Sec. 35 Twp. 14 R. 10W

Well No. 1 Vanek

Cities Service

Company

FIRST REPORT

Contractor

NE SE NE


SECTION PLAT

_____ Ft. from N. Line

990 _____ Ft. from S. Line

330 _____ Ft. from E. Line

_____ Ft. from W. Line

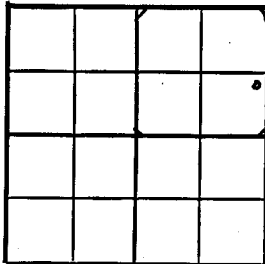

Ellsworth County

Location X

RECORD

Cased _____ in., _____ ft.

Sand _____

Gas _____

Oil _____

Total Depth _____

PRODUCTION

1st 24 hrs. Nat. _____

1st 24 hrs. after shot _____

Gas _____ Cu. Ft.

Dry Hole _____

Abandoned _____

Date

DEC 15 1948 19

S. J. LEWIS

Scout

Map No. 56 Sec. 35 Twp. 14 R. 10W

Well No. 1 Vanek

Cities Service

Company

ABANDONED

Contractor

NE SE NE


SECTION PLAT

_____ Ft. from N. Line

990 _____ Ft. from S. Line

330 _____ Ft. from E. Line

_____ Ft. from W. Line

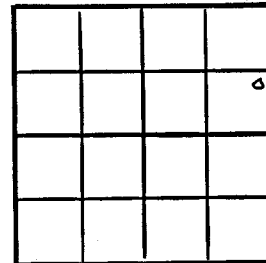

Ellsworth County

Location _____

RECORD

Cased _____ in., _____ ft.

Sand _____

Gas _____

Oil _____

Total Depth 3155

PRODUCTION

1st 24 hrs. Nat. _____

1st 24 hrs. after shot _____

Gas _____ Cu. Ft.

Dry Hole _____

Abandoned _____

Date

JAN 5 1949 19

S. J. LEWIS

Scout

KANSAS

Ellsworth

Sec. 35 Twp. 14 R. 10W ✓

Well No. #1 Vanek Farm

Cities Service

Company


Ft. from N. Line

990' Ft. from S. Line

330' Ft. from E. Line

Ft. from W. Line

NE SE NE

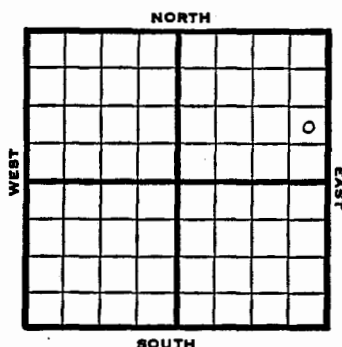

1948 Elev. 1650' REPORT

12/15 Location
12/22 8" @ 294'
Drlg 1835'
12/29 Lansing 2746'
Drlg 2845'

1949
1/5 Lans. 2746'
Arb. 3121'
TD 3155'

ABANDONED

KANSAS

Ellsworth

Section 35 Township 14 Range 10W

Well No. 1 Vanek

Company Cities Service

Wildcat

