

LAUGHLIN-SIMMONS & CO. OF KANSAS, INC.

Oil Well Elevations and Location
 2121 W. 18th 316-WH3-5351
 Wichita, Kansas 67203


APR 18 1969

April 16, 1969
 DATE

<u>Ellsworth 20</u>	<u>14s</u>	<u>10w</u>	<u>CW/2 SW NE</u>
COUNTY	S	T	R
<u>Glen N. Rupe</u>			<u>3</u>
OPERATOR			NO.
			<u>Pekarek</u>
			FARM

Mr. Glen N. Rupe
 222 Brown Building
 Wichita, Kansas 67202

Authorized by Florence Tel. No. 1683 DF
 Scale _____ Elevation _____

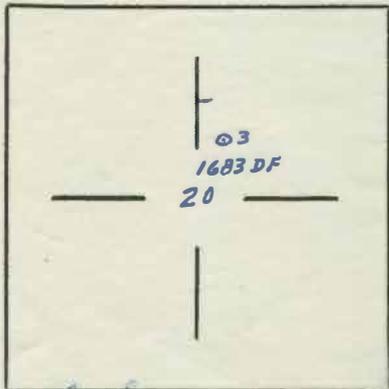

Remarks:

Left at rig - 5:25 am.

Thanks,


R. C. Moore

LS Engineer

Minimum Staking Charge:	_____
Elevation Charge:	<u>\$20.00</u>
Extra Time and Mileage:	<u># 20.00</u> ✓
TOTAL	_____

STATE CORPORATION COMMISSION
CONSERVATION DIVISION
500 INSURANCE BLDG.
212 NORTH MARKET
WICHITA 2, KANSAS

Township 14 South Range 10 West County Ellsworth Pool Wilson Creek

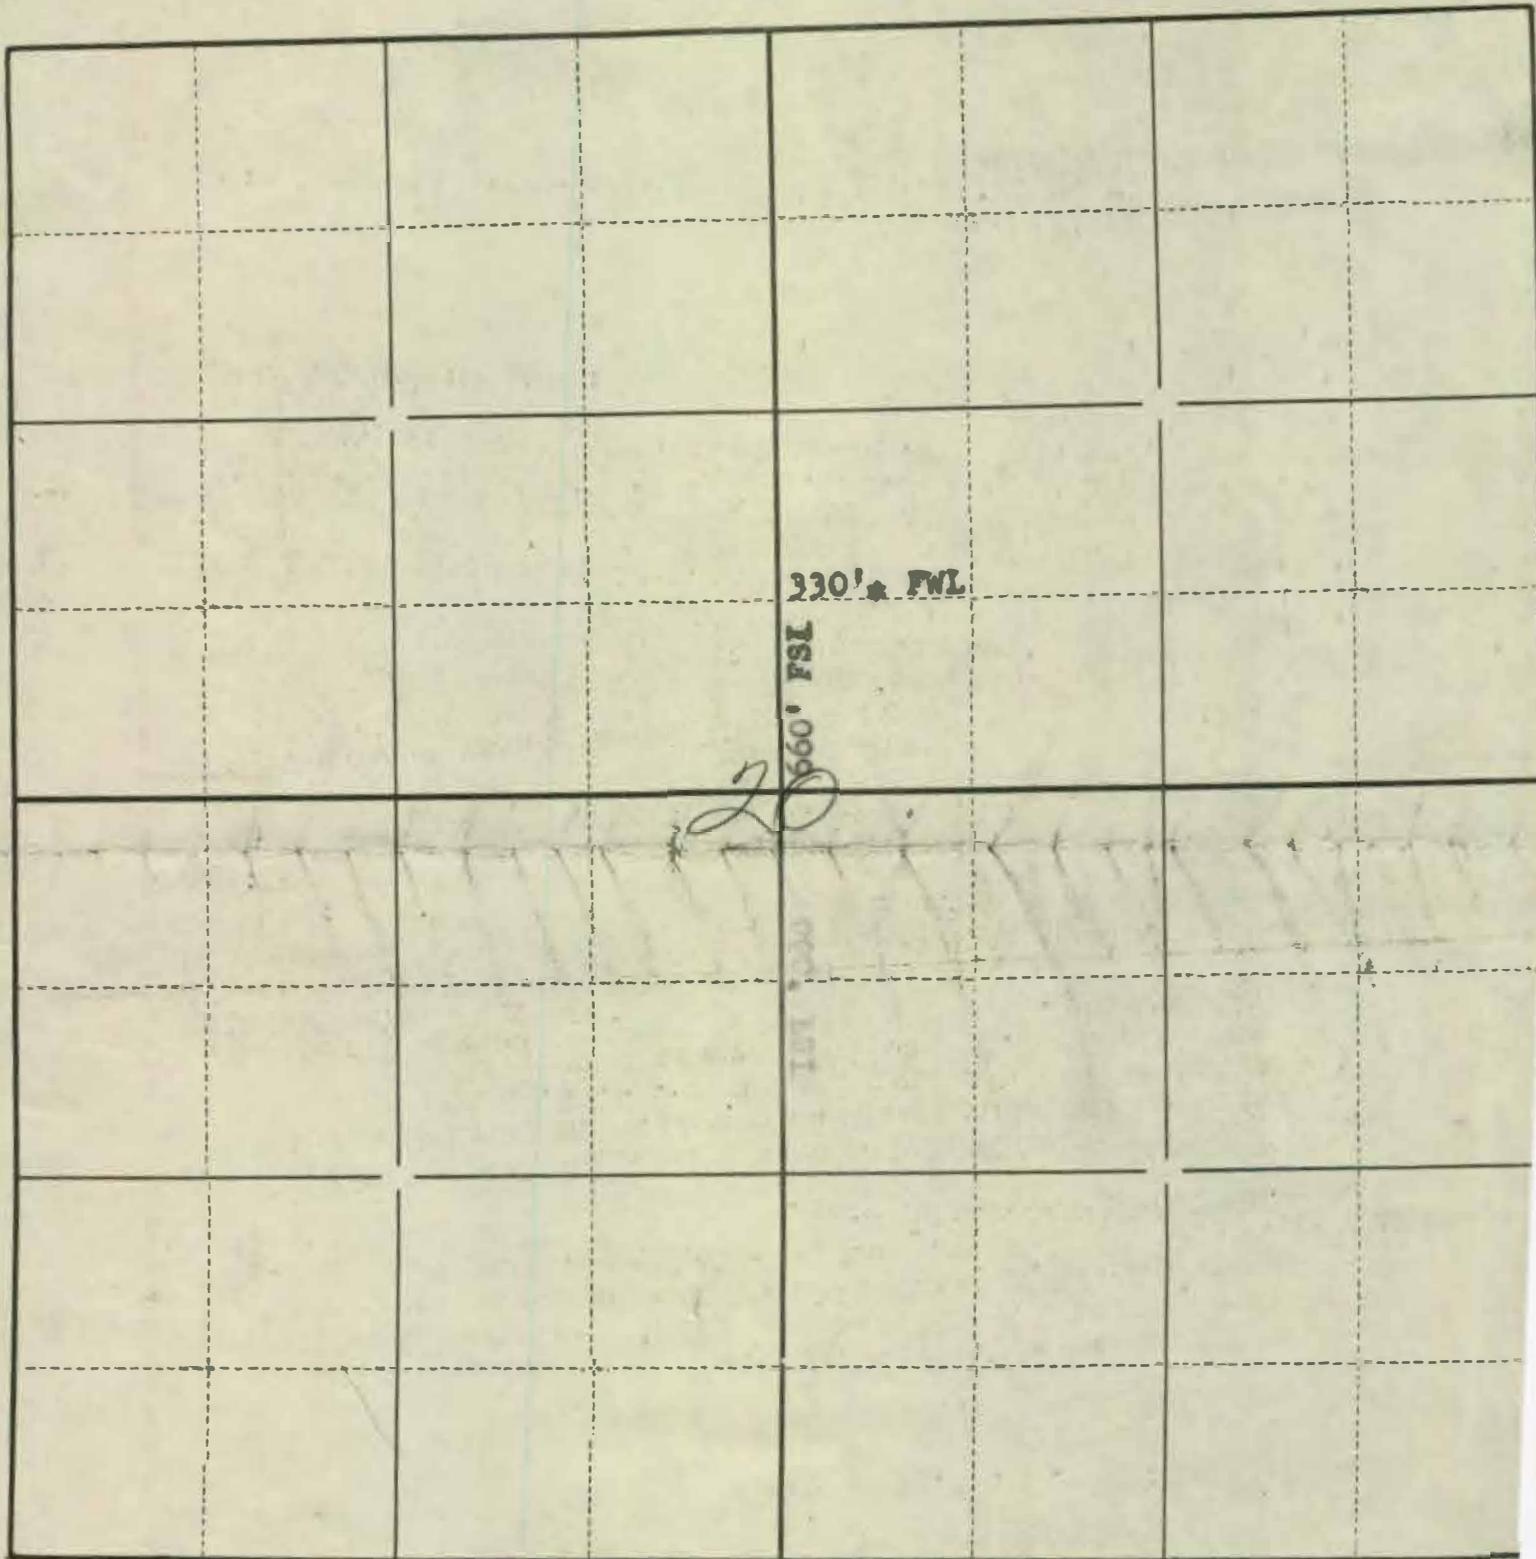

STATE OF KANSAS,
COUNTY OF SEDGWICK

I, G. N. Rupe, Operator of the Pekarek Lease

of Wichita, Kansas ~~do~~ hereby certify that the above locations, feet measurements and areas are true and correct to the best of my knowledge.

C W/2 SW/ NE/4 will consist of my twenty (20) acre #3 Pekarek Unit.

G. N. Rupe

Subscribed and sworn to before me this 14th day of April, 19 69

My commission expires 10-13-69

NOTARY PUBLIC