

LAUGHLIN-SIMMONS & CO. OF KANSAS, INC.
 OILWELL ELEVATIONS AND LOCATIONS
 11 W. 18TH STREET (316) WH 3-4581
 WICHITA, KANSAS 67203


August 22, 1960
 DATE

Ellsworth	17	14s	10w	SE SW SE
COUNTY	S	T	R	LOCATION
Glen N. Rupe				1
OPERATOR				Svara
				FARM

ELEVATION: 1702 G.C.
state

Mr. Glen N. Rupe
 222 Brown Building
 Wichita, Kansas 67202

SCALE: 2" = 1 Mile

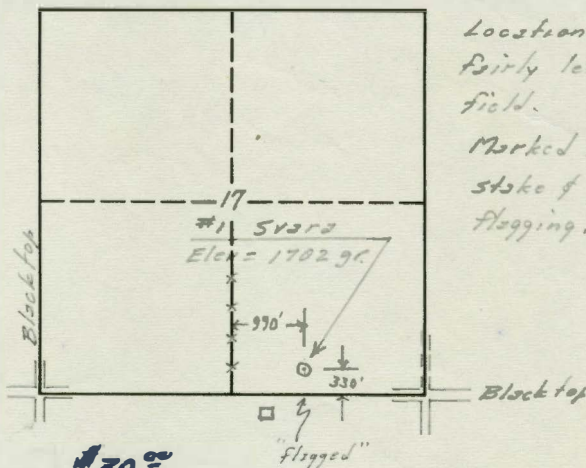

MINIMUM STAKING CHARGE: \$30.00

EXTRA TIME & MILEAGE: \$20.00

ELEVATION CHARGE: \$50.00

TOTAL: \$100.00

Thank you,
R. E. Moore

L-S ENGINEER