

Give All Information Completely
Make Required Affidavit
Mail or Deliver Report to:
Conservation Division
State Corporation Commission
212 No. Market
Wichita, Kansas 67202

WELL PLUGGING RECORD

Ellsworth County, Sec. 22 Twp. 14S Rge. 10 (E) W (W)

Location as "NE/CNW&SW&" or footage from lines NW NW NE

Lease Owner Glen N. Rupe- Gorski

Lease Name Soukup Well No. 2

Office Address Suite 925, 200 W. Douglas, Wichita, Kansas

Character of Well (completed as Oil, Gas or Dry Hole) D&A

Date well completed February 28, 19 71

Application for plugging filed February 28, 19 71

Application for plugging approved February 28, 19 71

Plugging commenced February 28, 19 71

Plugging completed February 28, 19 71

Reason for abandonment of well or producing formation D&A


If a producing well is abandoned, date of last production 19

Was permission obtained from the Conservation Division or its agents before plugging was commenced? yes

Name of Conservation Agent who supervised plugging of this well Gilbert Toman

Producing formation _____ Depth to top _____ Bottom _____ Total Depth of Well 2995 Feet

Show depth and thickness of all water, oil and gas formations.

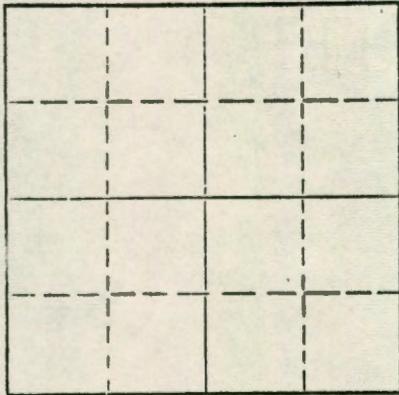

Locate well correctly on above Section Plat

OIL, GAS OR WATER RECORDS

CASING RECORD

| FORMATION | CONTENT | FROM | TO | SIZE | PUT IN | PULLED OUT |
|-----------|---------|------|----|--------|--------|------------|
| | | | | 8 5/8" | 267' | -0- |
| | | | | | | |
| | | | | | | |
| | | | | | | |
| | | | | | | |
| | | | | | | |
| | | | | | | |
| | | | | | | |

Describe in detail the manner in which the well was plugged, indicating where the mud fluid was placed and the method or methods used in introducing it into the hole. If cement or other plugs were used, state the character of same and depth placed, from _____ feet to _____ feet for each plug set.

Filled hole with mud up to 260'
1/2 sx hulls, plug w/25 sx cement
Filled hole up to 40' 1/2 sx hulls,
w/10 sx cement, plug @ rathole
w/1/2 sx hulls, 2 sx cement
Phole plugged @ 4:00 p.m.

(If additional description is necessary, use BACK of this sheet)


Name of Plugging Contractor Red Tiger Drilling Co.
Address 1720 Wichita Plaza, Wichita, Kansas 67202

STATE OF Kansas, COUNTY OF Sedgwick, ss.

Jim Farrice (employee of owner) or (owner or operator) of the above-described well, being first duly sworn on oath, says: That I have knowledge of the facts, statements, and matters herein contained and the log of the above-described well as filed and that the same are true and correct. So help me God.

(Signature) Jim Farrice
1720 Wichita Plaza, Wichita, Kansas
(Address)

Subscribed and sworn to before me this 1st day of March, 19 71

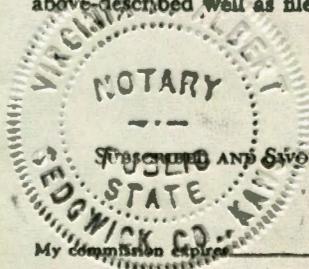

Virginia K. Albert
Notary Public.

My Commission Expires July 23, 1974

Original marked State Copy P11 2/27/71 Carlski 3/4/71

State of Kansas



State Corporation Commission

CONSERVATION DIVISION

(Oil, Gas and Water)

500 Insurance Bldg.

212 N. Market

WICHITA, KANSAS 67202

March 2, 1971

WELL PLUGGING AUTHORITY

| | |
|---------------------|---------------------------|
| Well No. | <u>2</u> |
| Lease | <u>Soukup</u> |
| Description | <u>NW NW NE 22-14-10W</u> |
| County | <u>Ellsworth</u> |
| Total Depth | <u>2995</u> |
| Plugging Contractor | Red Tiger Drilling Co. |


Glen N. Rupe & Arthur Gorski
Suite 925 - 200 W. Douglas
Wichita, Kansas 67202

Gentlemen:

This is your authority to plug the above subject well in accordance with the Rules and Regulations of the State Corporation Commission.

This authority is void after 90 days from the above date.

Very truly yours,

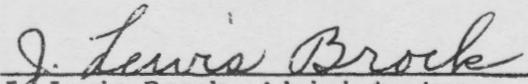
J. Lewis Brock, Administrator

Mr. Gilbert Toman Box 180 Holyrood, Kansas
is hereby assigned to supervise the plugging of the above
named well.