


STATE CORPORATION COMMISSION
CONSERVATION DIVISION
500 INSURANCE BLDG.
212 NORTH MARKET
WICHITA 2, KANSAS

Township 14 South Range 10 West County Ellsworth Pool Wilson Creek

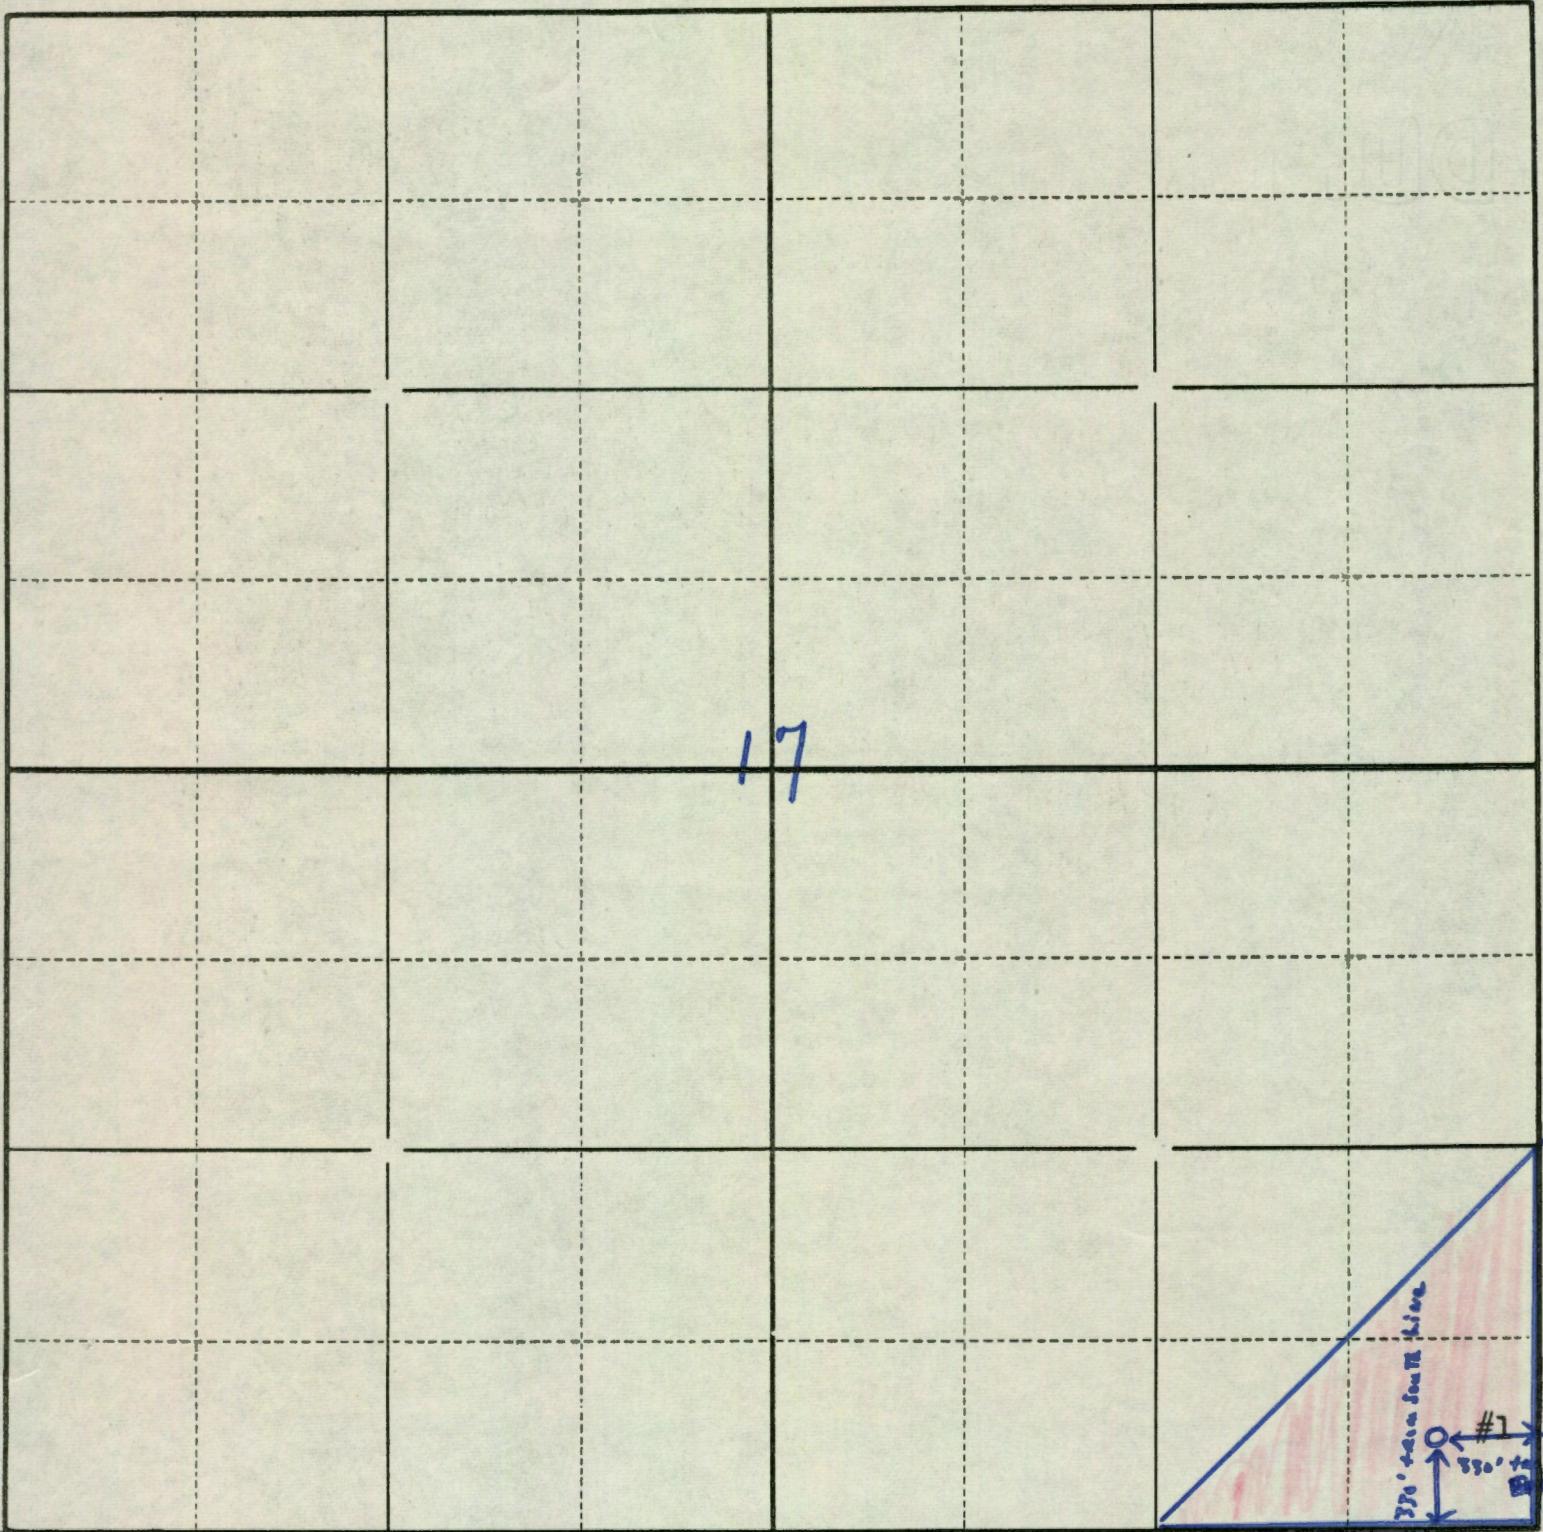

STATE OF KANSAS,
COUNTY OF SEDGWICK

I, G. N. Rupe, Suite 925 Olive W. Garvey Building, 200 West Douglas,
Wichita, Kansas

do hereby certify
that the above locations, feet measurements and areas are true and correct to the best of my knowledge
The above outlined acreage in SE/4 will consist of my twenty (20) acre
MAGEK #1 Unit.

G. N. Rupe
G. N. Rupe

Subscribed and sworn to before me this 1st day of March, 19 71

My commission expires September 16, 1973

Faye W. Leach
NOTARY PUBLIC
Faye W. Leach